



U.S. Public Land Survey Monument Record

Corner ID: S1/4 Sec. 1, T18N-R4W

21804010020

Type of Monument: Set Cast Iron TCP Monument in concrete

Sec. 1, T18N-R4W

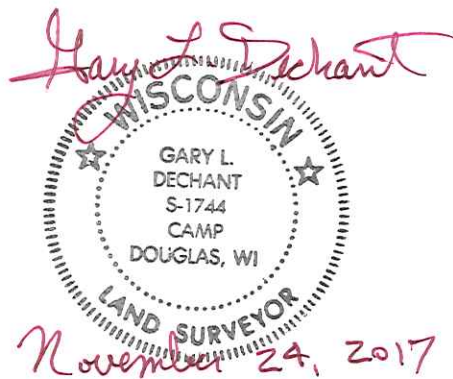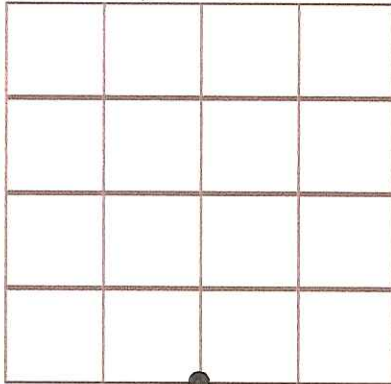

County Coordinates:

I do hereby certify that I have complied with AE 7 of the Wisconsin Administrative Code to best of my knowledge and belief.

Witnesses: Zachariah P. Dechant
Gary L. Dechant

Basis For Monument Location:

(Show info such as history, evidence, testimony, found or method of relocation)

Rodney Maxwell set a railroad spike by single proportionate measurement here as shown in CSR 1765 dated January 15, 2000.

Jonathan Schmitz in CSR 2271 dated March 6, 2013 shows he found no monument.

Found a 1/2" x 20" round iron rod lying flat approx 5' east.

Found and accepted Maxwell's Railroad spike and replaced it with a Cast Iron TCP monument and set in concrete as no other evidence was found.

