

#23



U.S. Public Land Survey Monument Record

Corner ID: SE Sec. 2, T18N-R4W

21804020000

Type of Monument: Set Cast Iron TCP Monument in concrete

Sec. 2, T18N-R4W

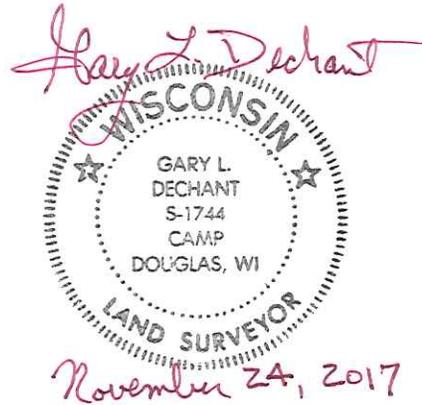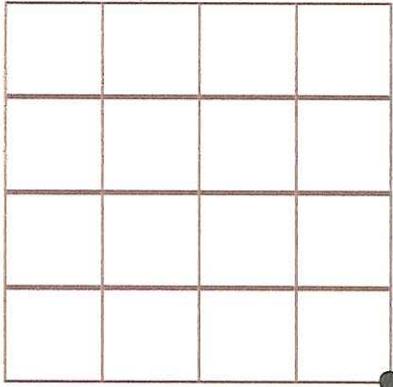

County Coordinates:

I do hereby certify that I have complied with AE 7 of the Wisconsin Administrative Code to best of my knowledge and belief.

Witnesses: Zachariah P. Dechant
Gary L. Dechant

Basis For Monument Location:

(Show info such as history, evidence, testimony, found or method of relocation)

Rodney Maxwell set a 3/4"x24" iron bar here as shown in CSR 1768 dated February 9, 1998 and again in CSR 1765 dated January 15, 2000.

Jonathan Schmitz used this iron bar in CSR 2271 dated March 6, 2013.

Found and accepted Maxwell's 3/4" iron bar as it fit occupation well. Replaced Maxwell's iron bar with a 1/4"x6' round iron bar and set in concrete. Set sign 2' south.

