

21804290000

I, Lawrence A. Feddersen, do hereby certify that on the 10th day of December 19 79, I found ~~XXXXXX~~ (no evidence) of the Southwest corner of Section 28, T 18 N, R 4 W Fourth Principal Meridian, and I re-established said corner according to the Wisconsin Statutes as shown and described hereon.

Dated this 21st day of December 19 79.

Lawrence A. Feddersen

Registered Land Surveyor

Title

History of corner establishment since Original Government Survey

There is no subsequent history of monument perpetuation since the Original U.S. Government Survey in Monroe County.

Description of corner evidence found:


A Harrison Monument was set in place of an old 1 inch square bar near the intersection of fencelines to the North and South and East and West.

Description of corner and witness monuments, references and accessories used to perpetuate the original or re-established location of this corner:

Witnesses to corner location:

Lawrence Feddersen

Mark Heidecke

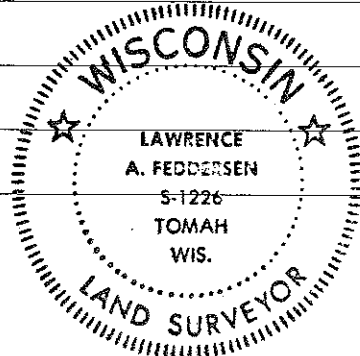

SURVEY CONTROL ORDER

Horizontal	_____
Vertical	_____

Nail and Washer in Blaze in 6" Red Oak

Harrison Monument Set at Southwest Corner Sec. 28

Old Fence tree-to-tree Nail and Washer in Blaze in 26" Red Oak

Nail and Washer in Blaze in 10" Hickory


Nail and Washer in Blaze in 13" Red Oak

WISCONSIN COORDINATE SYSTEM

Corner	East (X)	North (Y)	Elevation (Z)	Zone
Control Sta. Name				

~~XXXXXX~~ Town of Sparta

County of Monroe

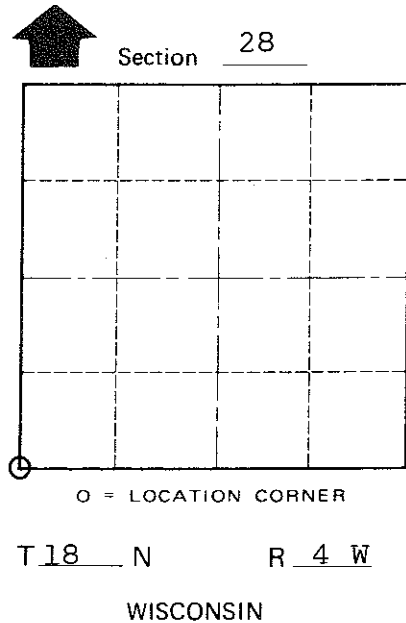

COUNTY SURVEYOR FORM NO. 1