

21804292000

I, Mark R. Heidecke, do hereby certify that on the 28th day of May 19 80, I found ~~XXXXXX~~ (no evidence) of the West 1/4 corner of Section 28, T 18 N, R 4 W Fourth Principal Meridian, and I re-established said corner according to the Wisconsin Statutes as shown and described hereon.

Dated this 5th day of June 19 80.

Mark R. Heidecke

Registered Land Surveyor

Title

History of corner establishment since Original Government Survey

There is no history of moument perpetuation since the Original U. S. Government Survey in Monroe County.

Description of corner evidence found:

Set corner in north-south fence line and half-way between the NW corner and the SW corner of Section 28. G.L.D. 12/19/1984


Description of corner and witness monuments, references and accessories used to perpetuate the original or re-established location of this corner:

Witnesses to corner location:

Mark R. Heidecke

Lawrence Feddersen

Harrison Monument Set at West 1/4 Corner Section 28 In fence line

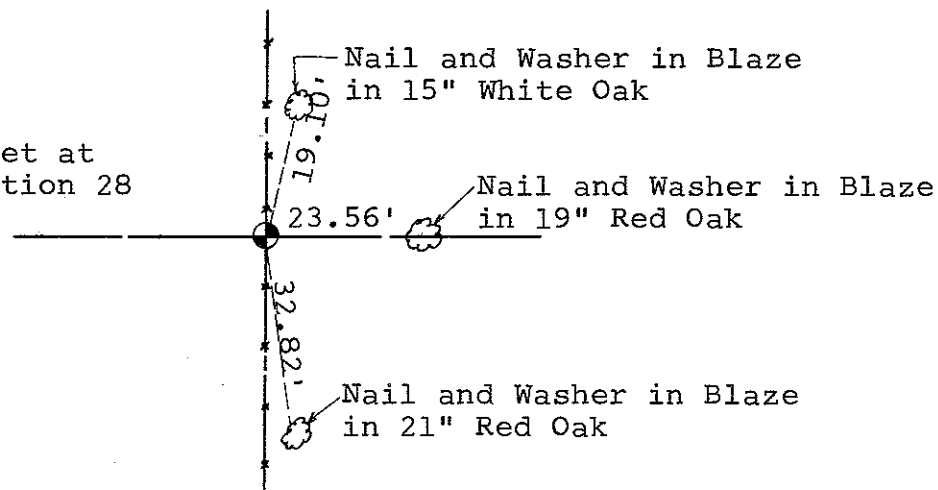

O = LOCATION CORNER

T 18 N R 4 W

WISCONSIN

COUNTY SURVEYOR FORM NO. 1

SURVEY CONTROL ORDER

Horizontal
Vertical

WISCONSIN COORDINATE SYSTEM

Corner	East (X)	North (Y)	Elevation (Z)	Zone
Control Sta. Name				

~~XXXXXX~~ City, Village or Town of Sparta

County of Monroe