

21804280020

I, Mark R. Heidecke, do hereby certify that on the 10th day of December 19 79, I found ~~(no evidence)~~ (no evidence) of the South 1/4 corner of Section 28, T 18 N, R 4 W Fourth Principal Meridian, and I re-established said corner according to the Wisconsin Statutes as shown and described hereon.

Dated this 18th day of December 19 79.

Mark R. Heidecke

Registered Land Surveyor
Title

History of corner establishment since Original Government Survey

There is no subsequent history of monument perpetuation since the Original U.S. Government Survey.

Description of corner evidence found:

A Harrison monument was set half way and on a straight line between the Southwest corner and the Southeast corner of Section 28. Occupation and monumentation in both Sections 28 and 33 support this location.

Description of corner and witness monuments, references and accessories used to perpetuate the original or re-established location of this corner:

Witnesses to corner location:

Mark R. Heidecke

Lawrence A. Feddersen

Nail and Washer in Blaze in 10" Red Oak

Nail and Washer in Blaze in 6" Hickory

14.81'

9.02'

13.58'

42'

Harrison Monument set at South 1/4 Corner Sec. 28


Nail and Washer in Blaze in 12" Red Oak

Nail and Washer in Blaze in 8" Hickory

62'

28.25'

Old downed fence

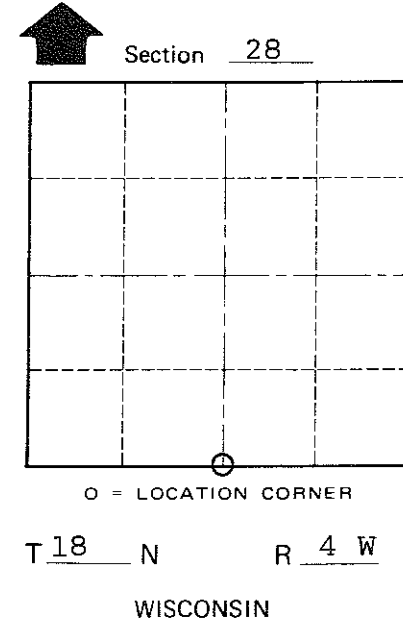

COUNTY SURVEYOR FORM NO. 1

SURVEY CONTROL ORDER

Horizontal
Vertical

WISCONSIN COORDINATE SYSTEM

Corner	East (X)	North (Y)	Elevation (Z)	Zone
Control Sta. Name				

~~City of Wilkes~~ Town of Sparta
County of Monroe