

CERTIFICATE

CERTIFIED LAND CORNER

No. 104

21804260020

I, Gary L. Dechant, do hereby certify that on the 16th day of July 1986, I found (evidence) (~~no evidence~~) of the N¹/₄ corner of Section 35, T 18 N, R 4 W Fourth Principal Meridian, and I re-established said corner according to the Wisconsin Statutes as shown and described hereon.

Dated this 17th day of July 1986.

Gary L. Dechant

Registered Land Surveyor-1744
Title

History of corner establishment since Original Government Survey

No known recorded history since the original government survey.

Description of corner evidence found:

Accepted fence corner as best possible evidence as it fits other section data extremely well.





Description of corner and witness monuments, references and accessories used to perpetuate the original or re-established location of this corner:

Witnesses to corner location:

David E. Madison

Gary L. Dechant

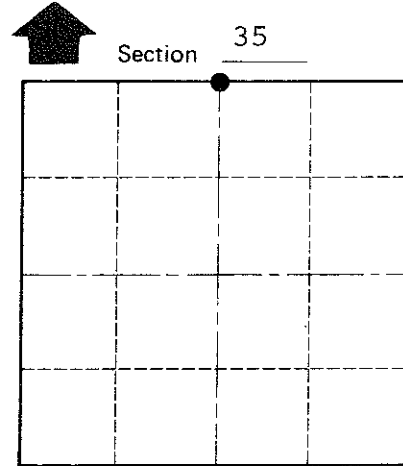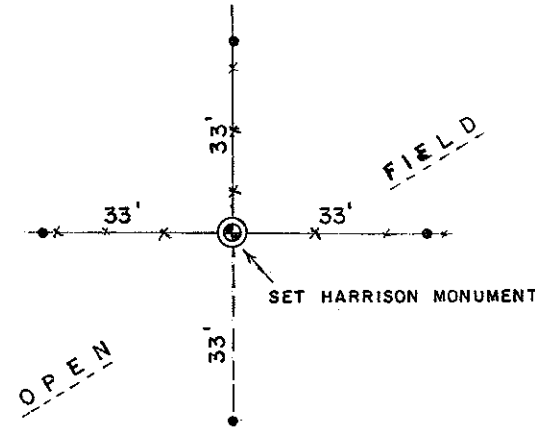

● = LOCATION CORNER

T 18 N R 4 W

WISCONSIN

● = SET 11/16" x 24" ROUND IRON BAR

COUNTY SURVEYOR FORM NO. 1

SURVEY CONTROL ORDER

Horizontal	_____
Vertical	_____

WISCONSIN COORDINATE SYSTEM

Corner	East (X)	North (Y)	Elevation (Z)	Zone
Control Sta. Name				

~~City, Village~~ Town Sparta
County of Monroe