

21804230000

I, Lawrence A. Feddersen, do hereby certify that on the 31st day of August 19 78, I found (evidence) ~~(no evidence)~~ of the Northwest corner of Section 25, T 18 N, R 4 W, Fourth Principal Meridian, and I re-established said corner according to the Wisconsin Statutes as shown and described hereon.

Dated this 13 day of Sept. 1978.

Lawrence A. Feddersen

REGISTERED LAND SURVEYOR S-1226  
Title

History of original corner establishment:

No subsequent history of corner perpetuation since the original U.S. Government Survey.

Description of corner evidence found:

This corner was re-established at a three-way fence intersection. Harold Wissestad, who owns land south of this corner, said that the intersection of the East-West fence and the ancient North-South fence has always been considered the corner, and that the new North-South fence was set by himself and his neighbor intentionally to the West of the actual corner by mutual agreement.





Description of corner and witness monuments, references and accessories used to perpetuate the original or re-established location of this corner:

Witnesses to corner location:

Lawrence A. Feddersen

Douglas J. Malliet

Steve Towne

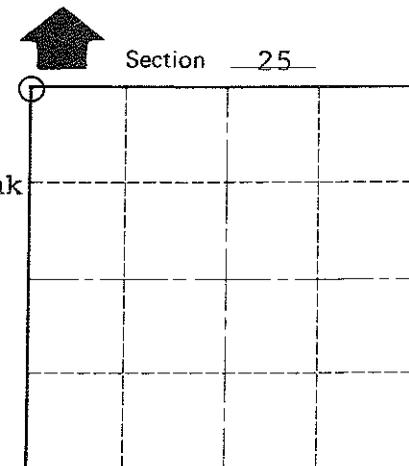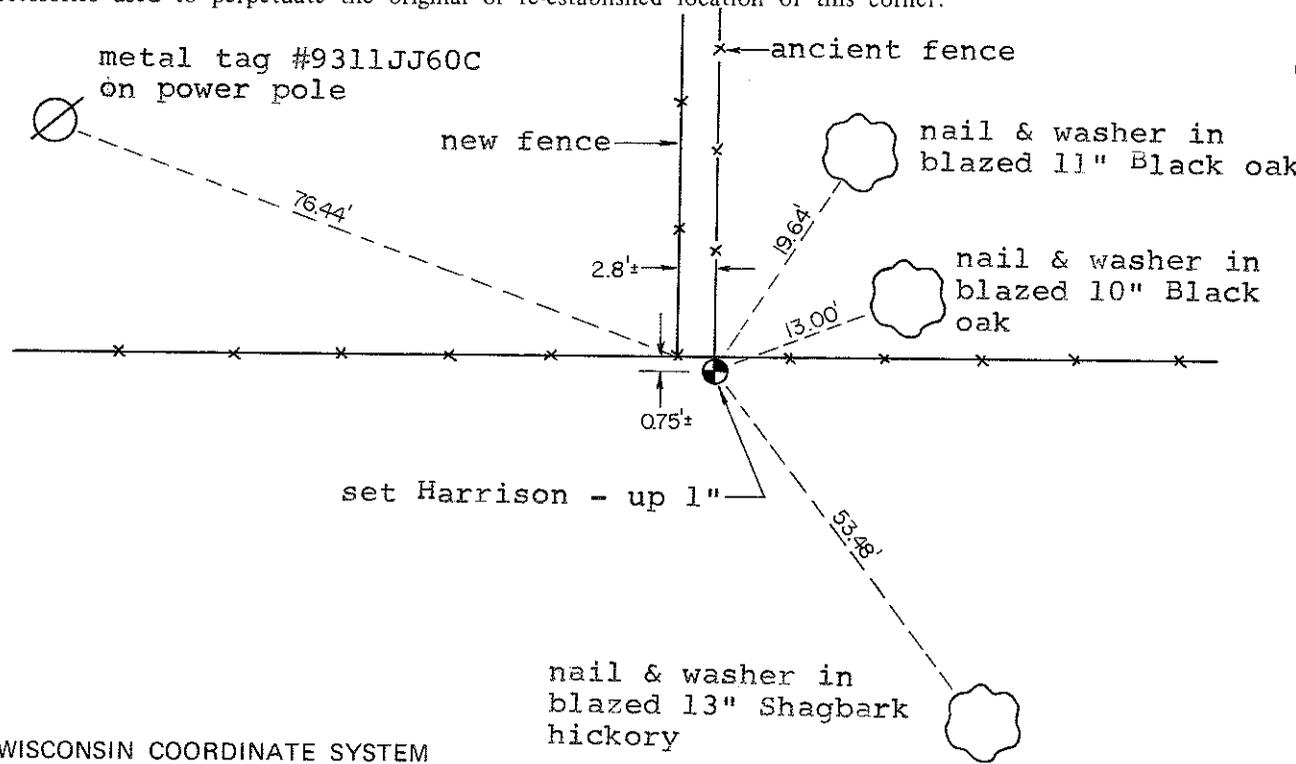

O = LOCATION CORNER

T 18 N R 4 W

WISCONSIN

COUNTY SURVEYOR FORM NO. 1

SURVEY CONTROL ORDER

Horizontal	_____
Vertical	_____

WISCONSIN COORDINATE SYSTEM

Corner	East (X)	North (Y)	Elevation (Z)	Zone
Control Sta. Name				

nail & washer in blazed 13" Shagbark hickory

~~XXXXXX~~ Town of SPARTA

County of MONROE