

CERTIFICATE

CERTIFIED LAND CORNER

No. 59

21804142000

I, Gary L. Dechant, do hereby certify that on the 14th day of Sept. 1994, I found (evidence) (~~no evidence~~) of the E/4 corner of Sec. 14, T 18 N, R 4 W Fourth Principal Meridian, and I re-established said corner according to the Wisconsin Statutes as shown and described hereon.

History of corner establishment since Original Government Survey

Fred Folden was here in June of 1909.

Description of corner evidence found:

Set by single proportionate measurement on line between section corners. Falls on line with existing fence going west.

Dated this 26th day of Sept. 1994.

Gary L. Dechant


R.L.S 1744  
Title

COUNTY SURVEYOR FORM NO. 1


Description of corner and witness monuments, references and accessories used to perpetuate the original or re-established location of this corner

Witnesses to corner location:

Gary L. Dechant

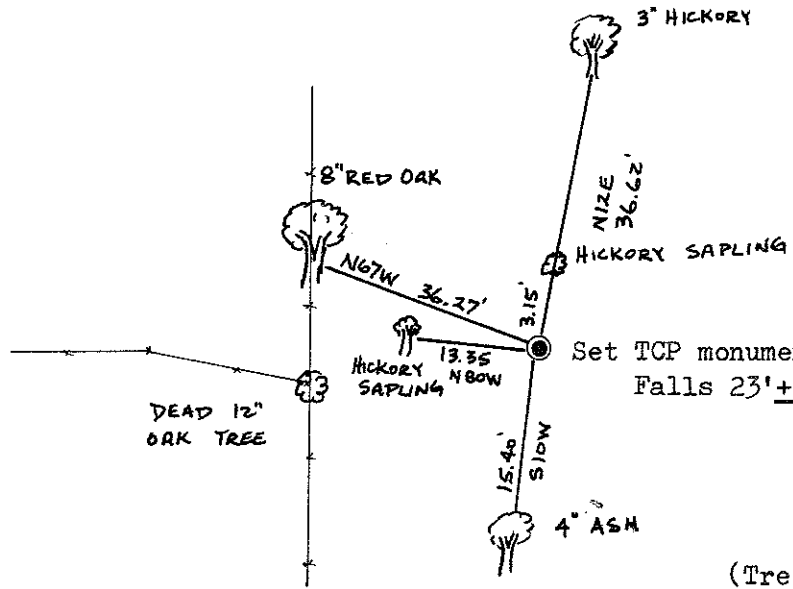

Gary L. Dechant  
WISCONSIN  
GARY L. DECHANT  
S-1744  
CAMP  
DOUGLAS, WI  
LAND SURVEYOR  
Sept. 26, 1994

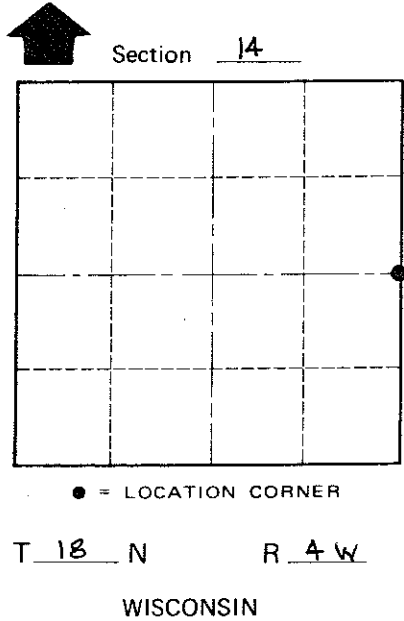

SURVEY CONTROL ORDER

Horizontal	_____
Vertical	_____

WISCONSIN COORDINATE SYSTEM

Corner	East (X)	North (Y)	Elevation (Z)	Zone
Control Sta. Name				

City, Village or Town LITTLE FALLS

County of MONROE