

**U. S. Public Land Corner
Maintenance**

54

Corner: W1/4 Sec. 18, T17N-R1E

21701132000

<u>Date</u>	<u>Crew</u>	<u>Monument type</u>
May 12 , 2021	Zachariah P. Dechant	Existing Harrison, intact, down 8", in N-S fence,
	Gary L. Dechant	Set new sign 1/2' north, 1978 power pole ties check.

References:

	<u>Bearing</u>	<u>Distance</u>
1) Set 2' section steel fence post, down 10" in field	N60E	27.06'
2) Set 2' section steel fence post, center of trail, 13' west of fence	S12W	71.19'
3) Set 2' section steel fence post, 5' NE of 13" Shagbark Hickory	S40W	99.27'
4) Set 2' section steel fence post, down 10" on south edge of field	S60W	60.17'

Compass bearings.
Trees double blazed.

Gary L. Dechant
WISCONSIN
GARY L.
DECHANT
S-1744
DOUGLAS, WI
LAND SURVEYOR
May 25, 2021

I, Lawrence A. Feddersen, do hereby certify that on the 22nd day of August 19 78, I found (evidence) ~~(XXXXXX)~~ of the W₁ corner of Section 18, T 17 N, R 1 E, Fourth Principal Meridian, and I re-established said corner according to the Wisconsin Statutes as shown and described hereon.

Dated this 13 day of Sept. 19 78.



History of original corner establishment:

No subsequent history of corner perpetuation since the original U.S. Government Survey.

Description of corner evidence found:

The corner was re-established at the intersection of a three-way fence. The occupied fence intersection was considered the best possible evidence and fell within tolerances of the Government Survey Notes.

REGISTERED LAND SURVEYOR S-1226
Title

See Reverse Side For Maintenance



Description of corner and witness monuments, references and accessories used to perpetuate the original or re-established location of this corner:

Witnesses to corner location:

Lawrence A. Feddersen

Douglas J. Malliet

Steve Towne

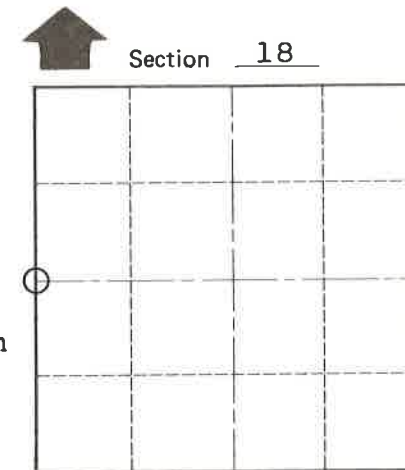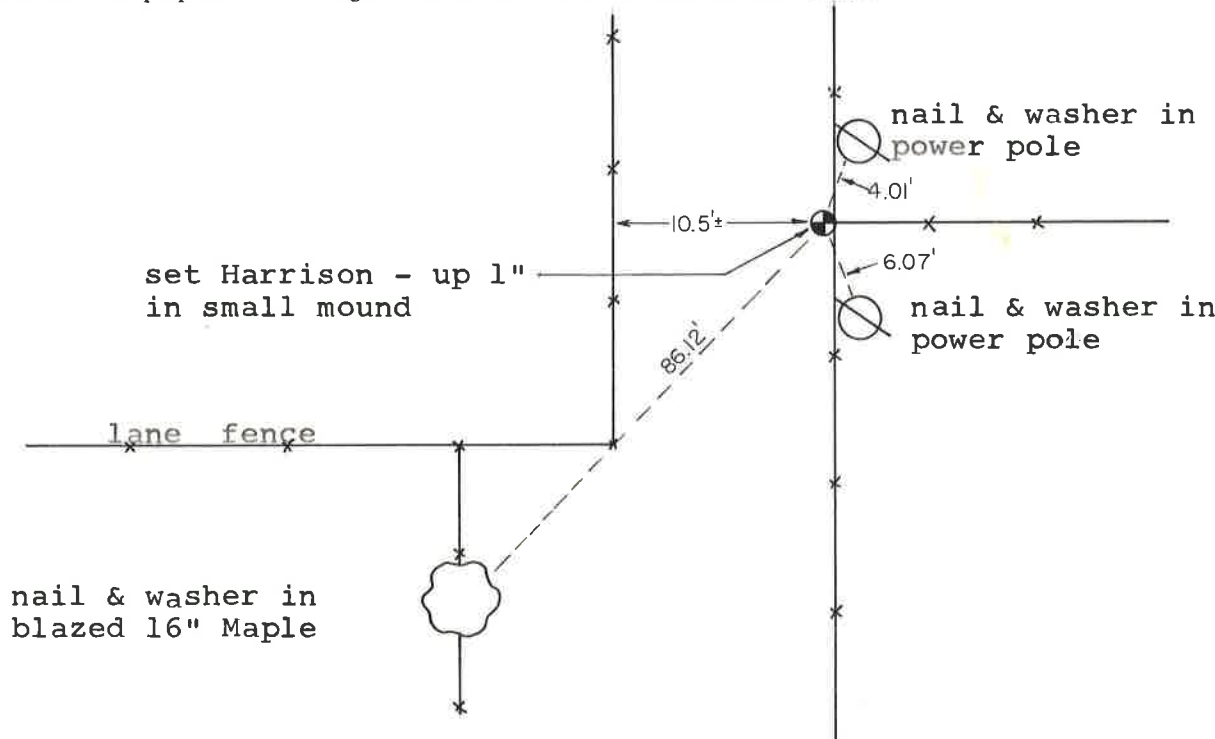

O = LOCATION CORNER

T 17 N R 1 E
WISCONSIN

SURVEY CONTROL ORDER

Horizontal	_____
Vertical	_____

WISCONSIN COORDINATE SYSTEM

Corner	East (X)	North (Y)	Elevation (Z)	Zone
Control Sta. Name				

~~XXXXXX~~ Town of OAKDALE

County of MONROE

COUNTY SURVEYOR FORM NO. 1