

78



**U.S. Public Land
Survey Monument Record**

Corner ID: E1/4 Sec 22, T19N-R1E

41901222000

Type of Monument: Set 1 1/4"x8' round iron bar

E1/4 Corner Sec. 22, T19N-R1E

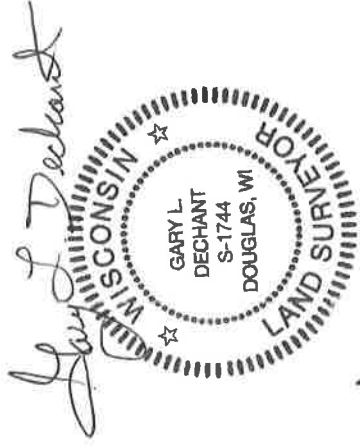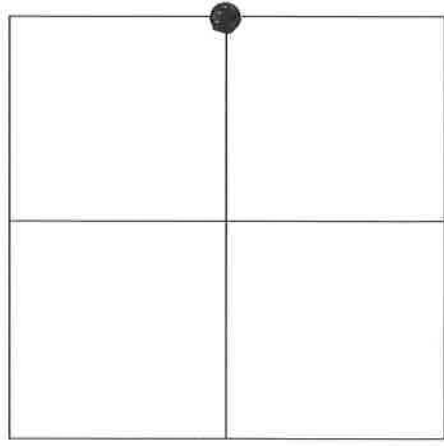

January 11, 2022

I certify that the U.S. Public Land Survey Monument Record is correct and complete to the best of my knowledge and belief.

County Coordinates:

Witnesses:

Al Hoff

Gary Dechant

Basis of Monumentation Location: (show info such as history, evidence, testimony, found or method of location)

Original Government survey was done by George Cole in November of 1851.

No other known history since the original government survey.

Found no evidence of corner. Set corner by single proportionate measurement.

