



**U.S. Public Land
Survey Monument Record**

Corner ID: S1/4 Sec 23, T19N-R1E

41901230020

Type of Monument: Set 1 1/4" x 8' round iron bar

S1/4 Corner Sec. 23, T19N-R1E

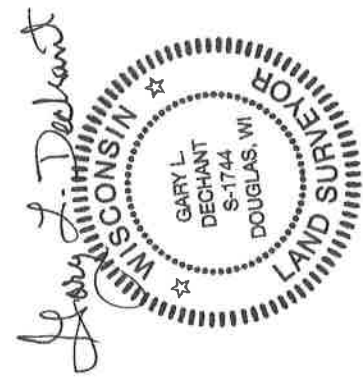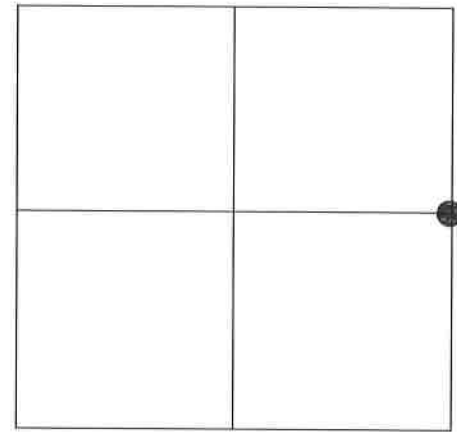

January 18, 2022

I certify that the U.S. Public Land Survey Monument Record is correct and complete to the best of my knowledge and belief.

Witnesses:

Al Hoff
Gary Dechant

Basis for Monumentation Location: (show info such as history, evidence, testimony, found or method of location)

Original Government survey was done by George Cole in November of 1851.

No other known history since the original government survey.

Found no evidence of corner. Set corner by single proportionate measurement.

- = Set 1 1/4" x 8' round iron bar, up 1'
Set sign 1' north
- = Set 3/4" x 24" round iron bar
Compass bearings

Field work: January 13, 2022

