


U.S. Public Land Survey Monument Record

Corner ID: E1/4 Sec 24, T19N-R1E
41901242000

Type of Monument: Found 2" capped pipe

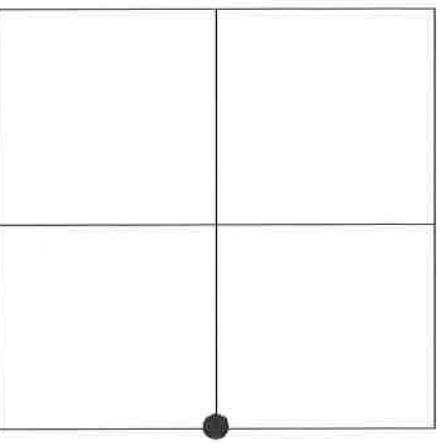

Gary L. Dechant
GARY L. DECHANT
S-1744
DOUGLAS, WI
LAND SURVEYOR
December 28, 2021

I certify that the U.S. Public Land Survey Monument Record is correct and complete to the best of my knowledge and belief.

County Coordinates:

Witnesses:

Al Hoff
Gary Dechant

Basis for Monumentation Location: (show info such as history, evidence, testimony, found or method of location)

Original Government survey was done by G.R. Stuntz & J.O. Sargent in May of 1851.
No other know history since the original government survey.
Found 2" capped iron pipe most likely set by S. Kennedy as he worked in the Town of Scott during the 1930's-40's.

○ = Set 3/4"x24" iron pipe

Found scribed 2" capped iron pipe in mound with pit to the south. Set sign 1' north.

