



118

**U.S. Public Land
Survey Monument Record**

Corner ID: E1/4 Sec 34, T19N-R1E

41901342000

Type of Monument: Set 1 1/4"x8' iron pipe

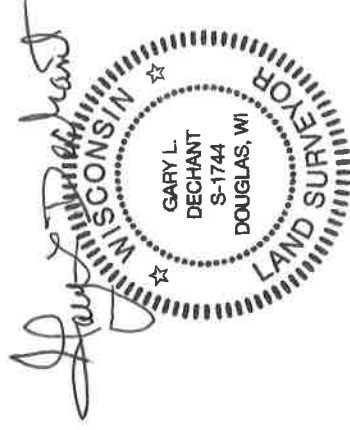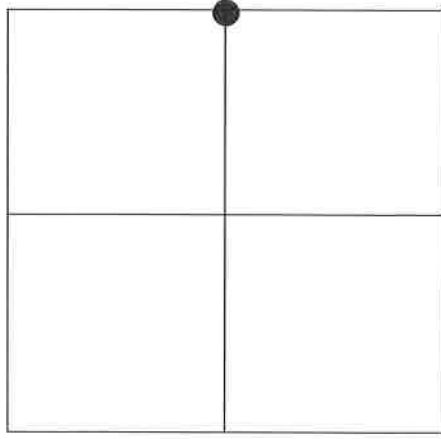

December 28, 2021

I certify that the U.S. Public Land Survey Monument Record is correct and complete to the best of my knowledge and belief.

County Coordinates: 428373.2296

746979.3210

Witnesses:

Al Hoff

Gary Dechant

Basis for Monumentation Location: (show info such as history, evidence, testimony, found or method of location)

Original Government survey was done by George Cole in November of 1851.

No other know history since the original government survey.

Found no evidence of corner. Set corner by single proportionate measurement.

Set 1 1/4"x8' iron pipe at corner. Set sign 1/2' north.

Corner falls out in swamp approximately 550' east of reservoir. No ties taken.