

# 98

# U.S. Public Land



Corner ID: E1/4 Sec. 27, T19N-R1E

## Survey Monument Record

41901272000

Type of Monument: Set 1 1/4" x 8' round iron bar

E 1/4 Corner Sec. 27, T19N-R1E

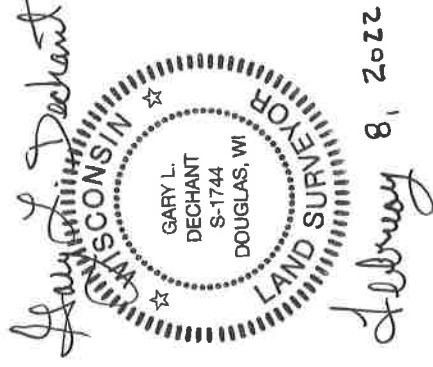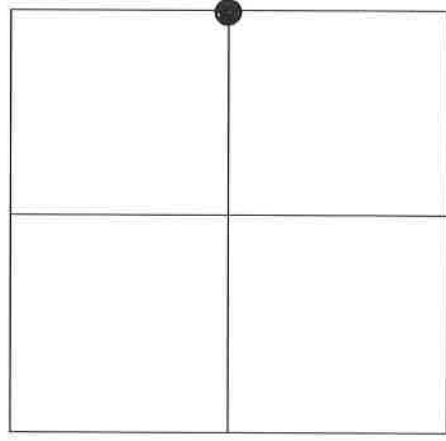

I certify that the U.S. Public Land Survey Monument Record is correct and complete to the best of my knowledge and belief.

### Witnesses:

Al Hoff, Zachariah P. Dechant

Gary Dechant

**Basis for Monumentation Location:** (show info such as history, evidence, testimony, found or method of location)

Original Government survey was done by George Cole in November of 1851.

No other known history since the original government survey.

Found no evidence of corner. Set corner by single proportionate measurement.

● = Set 1 1/4" x 8' round iron bar

Set sign 1' north

○ = Set 3/4"x24" round iron bar

Compass bearings  
trees double blazed

3' WHITE PINE



10" JACK PINE



WEST  
71.06

ditch.

548E

S15W  
51.6

WHITE PINE  
SAPLING

28.75'

A

3' WHITE PINE

# 98