

117



**U.S. Public Land
Survey Monument Record**

Corner ID: E1/4 Sec. 33, T19N-R1E

41901332000

Type of Monument: Set 1 1/4" x 8' round iron bar

E 1/4 Corner Sec. 33, T19N-R1E

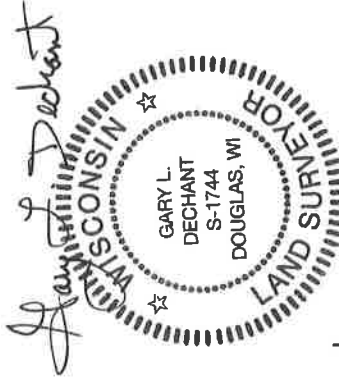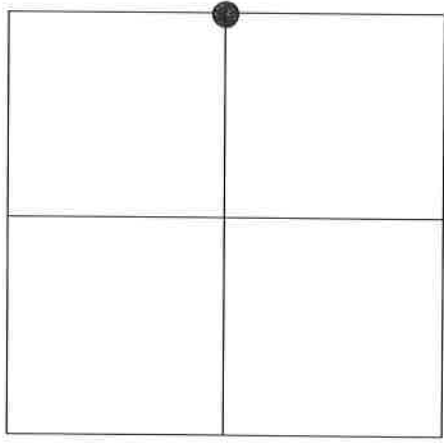

February 8, 2022

I certify that the U.S. Public Land Survey Monument Record is correct and complete to the best of my knowledge and belief.

Witnesses:

Al Hoff

Gary Dechant

Basis for Monumentation Location: (show info such as history, evidence, testimony, found or method of location)

Original Government survey was done by George Cole in November of 1851.

No other known history since the original government survey.

Found no evidence of corner. Set corner by single proportionate measurement. (best as possible in reservoir)

Set 1 1/4" x 8' round iron bar in reservoir.

Set flush with water level. No ties near because of reservoir and swamp.

Coordinates: 428701.8690
741712.2950 NAD 83(2011)