


21805120000

U. S. PUBLIC LAND SURVEY MONUMENT RECORD

SECTION 12 T 18 N, R 5 W, TOWN OF BURNS

LA CROSSE COUNTY

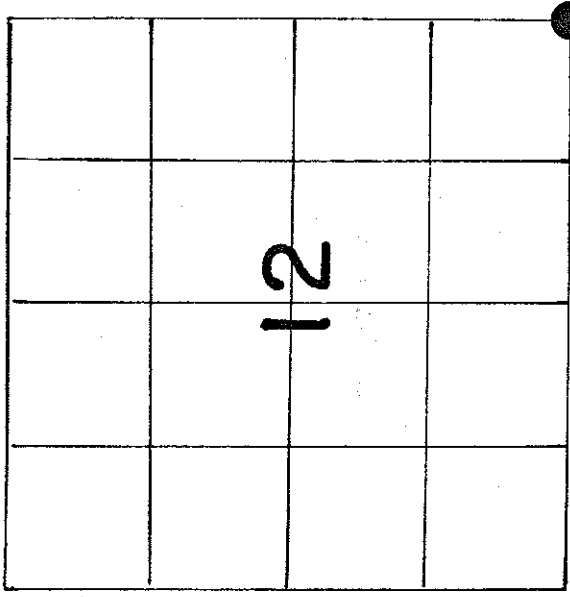

LOCATION OF LANDMARK

WISCONSIN COORDINATE SYSTEM	
North	
East	
Theta Angle	
Horiz. Order	
Vert. Order	
TYPE OF LANDMARK BERNTSEN	
BEARINGS ARE REFERENCED TO Assumed	

Crew: William Jung  
8/8/85

SIGN PLACED 11-07-89 A.J.

Describe any record evidence, monument evidence, testimonial evidence or any other material evidence you considered and whether the monument was found or restored through acceptance of an obliterated evidence location.

I found a 22" white oak, N23W, 14.22 feet from my final corner. The original notes called for a 9" white oak, N20W 21 links (14.24 feet to the center of the tree). After surveying out Section 12, I came to the opinion that the 22" white oak was probably the original tree. Using the tree my final distance to the East 1/4 corner is almost equal to the distance between the East 1/4 and NE corners. Also, my final total along the South line of the section fits the original within about 4 feet. Also too, if one connects the SW and SE corners

\*(continued below)  
Describe or show any material discrepancy between the location of the restored corner and that of the corner previously restored or reestablished.

(Continued)

with a straight line, the existing fence corner at the S1/16SW is only 1.5 feet or so off line. On a final note, if one compares the difference between the bearing on the North line of the section and a straight line between the SW and SE corners, you would find that it fits the difference between the original variations within 3 minutes. I searched the area thoroughly and found no other evidence of the original corner. Because of rock it was very hard digging.

No discrepancies known.