

**U. S. Public Land Corner  
Maintenance**

#13

Corner: NW Sec. 6, T15N-R3W

21604360000

<u>Date</u>	<u>Crew</u>	<u>Monument type</u>
March 10, 2022	Zachariah P. Dechant Gary L. Dechant	Found Harrison intact at 4-way fence corner, on top of steep ridge, verified by all four 1984 bearing trees.

References:

	<u>Bearing</u>	<u>Distance</u>
1) Set 3/4"x24" round iron bar, 4' SW of 7" Ironwood	N33E	32.25'
2) Set 3/4"x24" round iron bar NW side of rock, up 12"	S71E	42.14'
3) Set 3/4"x24" round iron bar, 4' NE of 7" White Oak	S41W	32.54'
4) Set 3/4"x24" round iron bar 4' SE of 9" Hickory, 11' west of fence	N26W	44.17'

Compass bearings  
Trees double blazed



CERTIFICATE

I, Garold A. Sime, do hereby certify that on the 27th day of July 1984, I found (evidence) ~~(no evidence)~~ of the NW corner of Section 6, T15 N, R 3 W Fourth Principal Meridian, and I re-established said corner according to the Wisconsin Statutes as shown and described hereon.

Dated this 15th day of Oct. 1984.

Garold A. Sime

Garold A. Sime, R.L.S. 1261  
Title

CERTIFIED LAND CORNER

History of corner establishment since Original Government Survey

A.S. Ingalls was here in May of 1873  
Fred Holden was here in April of 1903

Description of corner evidence found:

Accepted fence corner as best available evidence

No. 13

**21604360000**

**See Reverse Side  
For Maintenance**

COUNTY SURVEYOR FORM NO. 1



Description of corner and witness monuments, references and accessories used to perpetuate the original or re-established location of this corner:

Set Harrison Monument at corner

Witnesses to corner location:

G.A. Sime

Dallas Wilhite

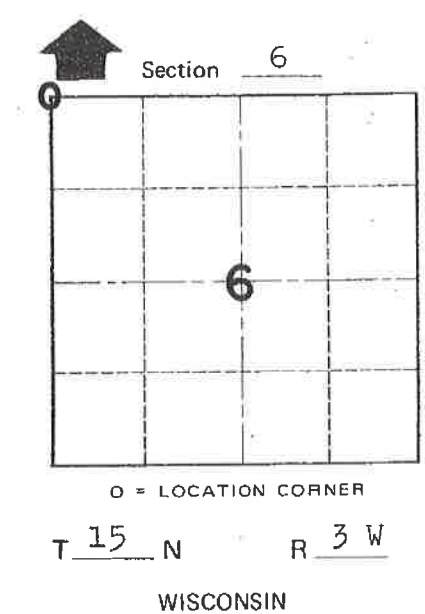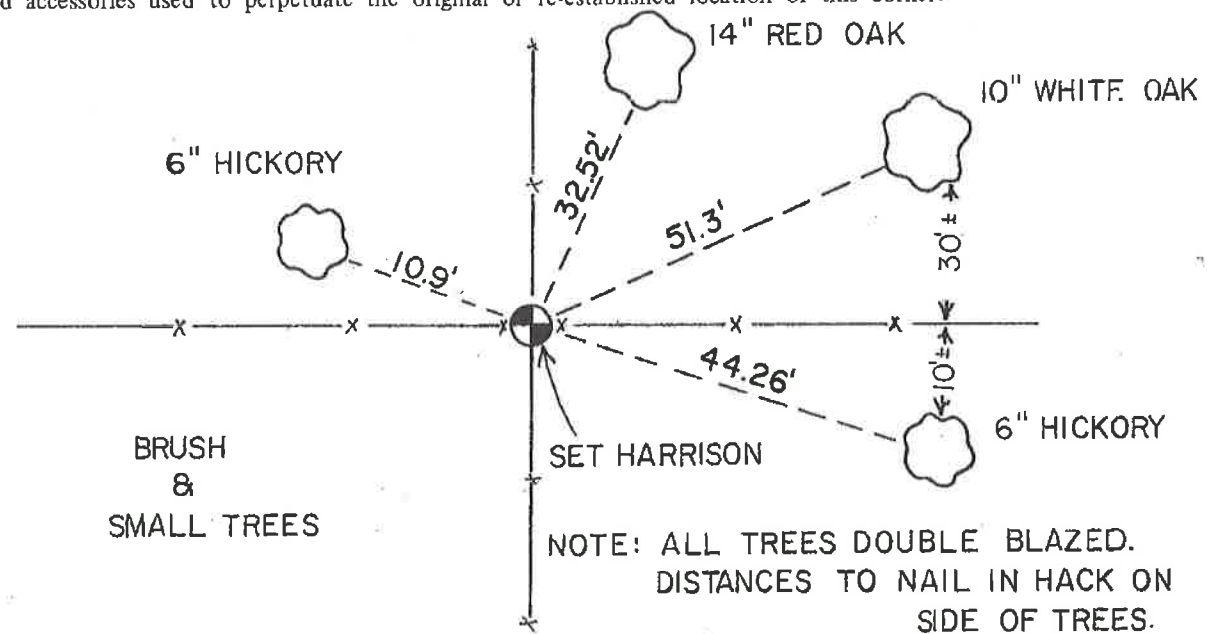

SURVEY CONTROL ORDER

Horizontal \_\_\_\_\_  
Vertical \_\_\_\_\_

WISCONSIN COORDINATE SYSTEM

Corner	East (X)	North (Y)	Elevation (Z)	Zone
Control Sta. Name				

City, Village or Town Jefferson  
County of Monroe