

U. S. PUBLIC LAND CORNER

#37

MAINTENANCE

Corner ID: W1/4 Sec. 10, T16N-R1E
41601092000

<u>DATE</u>	<u>CREW</u>	<u>MONUMENT INFO</u>
February 21, 2022	Zachariah P. Dechant Gary L. Dechant	Found 2½" outside diameter iron pipe up 2'. Lowered to 1' up above ground level. 17' west of north/south creek, steam from west intersection. Public fishing sign ½' east. Corner in north-south fence.

	<u>Bearing</u>	<u>Distance</u>
1) Set 2' section of steel fence post 10' south of 36" double Cottonwood, 3' east of fence	N4E	20.03'
2) Set ¾"x6' round iron bar in swamp	N63E	49.55'
3) Set ¾"x6' round iron bar in swamp, 16' west of fence	S32W	30.94'
4) Set 2' section of steel fence post, 5" SE of 14" White Pine 19' west of fence	N18W	64.75'

Gary L. Dechant

February 22, 2022

I, William C. Jung, do hereby certify that on the ninth day of July 1980, I found (no evidence) of the West 1/4 corner of Section 10, T 16 N, R 1 E Fourth Principal Meridian, and I re-established said corner according to the Wisconsin Statutes as shown and described hereon.

Dated this 23rd day of Feb. 1981.

William C. Jung

William C. Jung - R.L.S. 1323
Title

History of corner establishment since Original Government Survey

No recorded history since the O.G.S.

Description of corner evidence found:

Measured between a Harrison at the S.W. corner of Section 10 and the occupied fence corner at the W 1/16 SW corner. Set the W 1/16 corner on line with the S.W. corner and the occupied W 1/16 SW corner and at the same distance as between the two afore-said corners.

See Reverse Side For Maintenance

Description of corner and witness monuments, references and accessories used to perpetuate the original or re-established location of this corner:




Approved: **HARLEY A. SIME**
MONROE CO. SURVEYOR

Witnesses to corner location:

W. Jung

G. De Chant

C. Dade

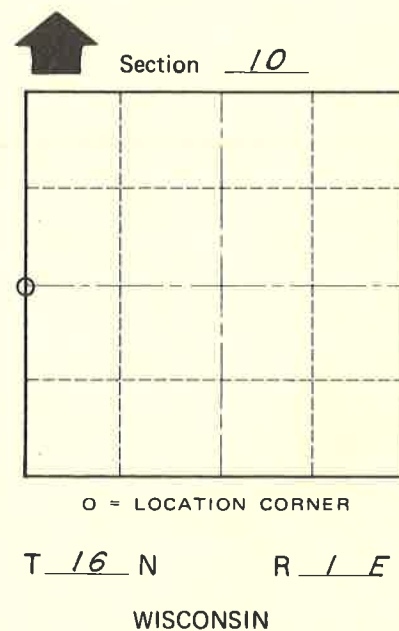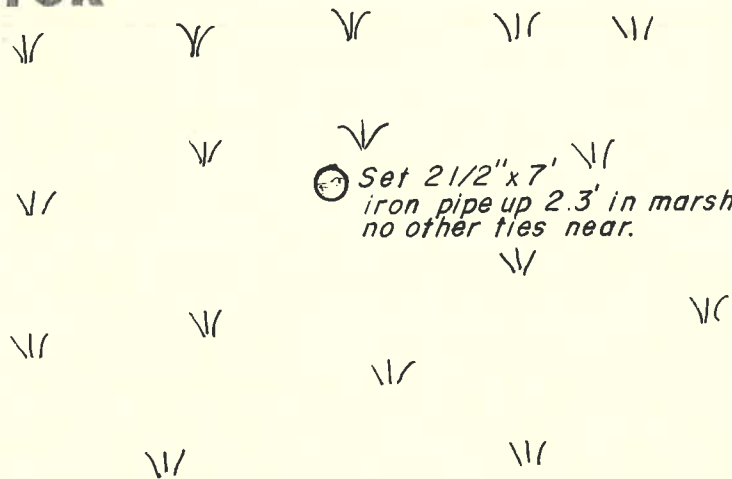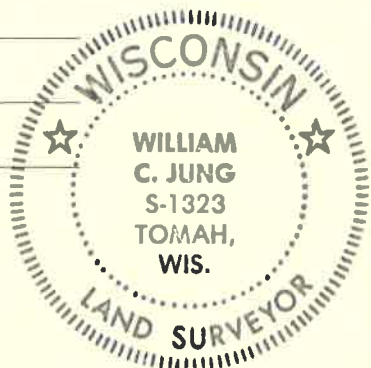

SURVEY CONTROL ORDER

Horizontal	_____
Vertical	_____

WISCONSIN COORDINATE SYSTEM

Corner	East (X)	North (Y)	Elevation (Z)	Zone
Control Sta. Name				

~~City, Village or~~ Town of Clifton
County of Monroe
Wisconsin

COUNTY SURVEYOR FORM NO. 1