


**U.S. PUBLIC LAND CORNER
MAINTENANCE**

#68

**Corner ID: S1/4 Sec. 16, T19N-R1E
41901160020**

<u>DATE</u>	<u>CREW</u>	<u>MONUMENT INFO</u>
February 9, 2022	Zachariah P. Dechant Gary L. Dechant	Replaced deteriorating 2" iron pipe with 1 1/4"x8' round iron bar, Set sign 1' north. 170' west of Dead Creek. Verified with 1985 bearing tree S36E, 181.73'.
		<u>Bearing</u> <u>Distance</u>
1) Set 3/4"x 24" round iron bar in center of old windmill tower being used for a deer stand		S38E 184.07'
2) Set 3/4"x 24" round iron bar 15' NE of 24" White Pine		S15W 99.02'
3) Set 3/4"x24" round iron bar 4' SE of 5" White Pine		N50W 76.38'
4) Set 3/4"x24" round iron bar 3' South of 3" White Pine		North 32.34'

Compass bearings
Trees double blazed

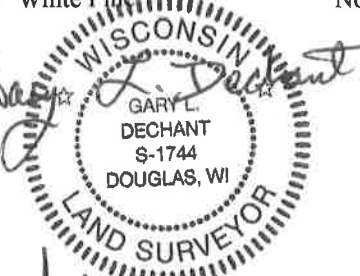Gary L. Dechant

February 15, 2022

41901160020

I, GARY L. DECHANT, do hereby certify that on the 17 day of FEBRUARY 19 85, I found ~~(evidence)~~ (no evidence) of the S 1/4 corner of SECTION 16, T 19 N, R 1 E Fourth Principal Meridian, and I re-established said corner according to the Wisconsin Statutes as shown and described hereon.

Dated this 4 day of MARCH 19 85.

Gary L. Dechant
REGISTERED LAND SURVEYOR, S-1744
Title

History of corner establishment since Original Government Survey

No KNOWN HISTORY SINCE THE ORIGINAL GOVERNMENT SURVEY.

Description of corner evidence found:

SET CORNER BY SINGLE PROPORTIONATE MEASUREMENT.

See Reverse Side For Maintenance

Description of corner and witness monuments, references and accessories used to perpetuate the original or re-established location of this corner:

(NO OTHER TIES IN AREA)

Witnesses to corner location:

DANNY L. DRAEGER D/D

GARY L. DECHANT D/K



4" JACK PINE




132.96'
S85W

SET 2" x 8' IRON PIPE IN SWAMP, UP 2'±


170'±

S36E
181.73'

7" JACK PINE ON BANK OF CREEK

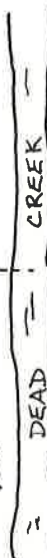

DEAD CREEK

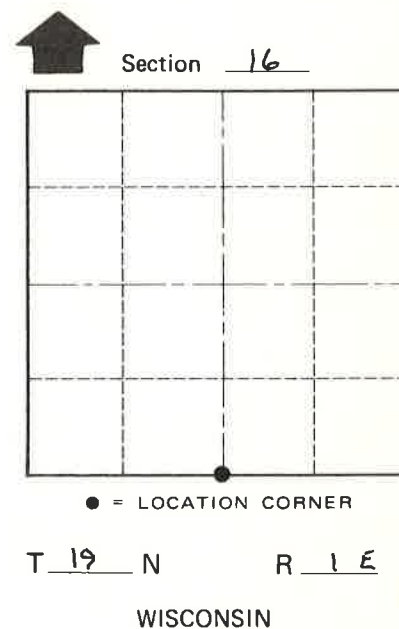

(TREES DOUBLE BLAZED WITH NAILS SET)

SURVEY CONTROL ORDER

Horizontal _____

Vertical _____

WISCONSIN COORDINATE SYSTEM

Corner	East (X)	North (Y)	Elevation (Z)	Zone
Control Sta. Name				

City, Village or Town SCOTT

County of MONROE

COUNTY SURVEYOR FORM NO. 1