

59 B


U.S. Public Land Survey Monument Record

Corner ID: C1/4 Sec. 13, T16N-R1E

41601132020

Type of Monument: Set 1 1/4"x4' round iron bar April 4, 2022

C1/4 Sec. 13, T16N-R1E

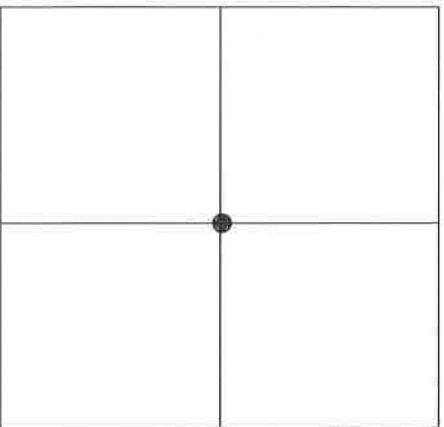

I certify that the U.S. Public Land Survey Monument Record is correct and complete to the best of my knowledge and belief.

Witnesses:

Zachariah P. Dechant
Gary Dechant

Basis for Monumentation Location: (show info such as history, evidence, testimony, found or method of location)

No known history. Set at intersection of quarter lines as per law.

Falls in line with fence running south. Fence running east very sporadic because of rough terrain.

○=Set 1 1/4" x 4' round iron bar

○=Set 3/4"x24" round iron bar

Compass bearings.

Trees double blazed.

