

**U. S. Public Land Corner
Maintenance**

70

Corner: S1/4 Sec. 17, T16N-R1E

41601170020

<u>Date</u>	<u>Crew</u>	<u>Monument type</u>
June 13, 2022	Zachariah P. Dechant Gary L. Dechant	Found Harrison intact, 2' east of fence corner, Set sign 1' north.

<u>References:</u>	<u>Bearing</u>	<u>Distance</u>
1) Set 3/4"x24" round iron bar, down 12" edge of field, 5' east of fence	N18E	16.00'
2) Set 3/4"x24" round iron bar, down 12" edge of field	S42E	24.74'
3) Set 3/4" x24" round iron bar, down 12" edge of field, 5' west of fence	S44W	11.37'
4) Set 3/4"x24" round iron bar, down 12", edge of field, 5' west o fence	N27W	14.62'

Compass bearings
Trees double blazed

Gary L. Dechant

June 15, 2022

I, Harley A. Sime, do hereby certify that on the 26th day of March 1980, I found (evidence) ~~(monument)~~ of the S. 1/4 corner of Sec. 17, T 16 N, R 1 E, Fourth Principal Meridian, and I re-established said corner according to the Wisconsin Statutes as shown and described hereon.

Dated this 7th day of April 1980.

Harley A. Sime R.L.S. 355

County Surveyor

History of original corner establishment:
No known history since the original government survey.

Description of corner evidence found:
Accepted a 3-way fence corner as best available evidence.

See Reverse Side For Maintenance

COUNTY SURVEYOR FORM NO. 1



Description of corner and witness monuments, references and accessories used to perpetuate the original or re-established location of this corner:

Witnesses to corner location:

G. Dechant

C. Dade

T. Tormoen

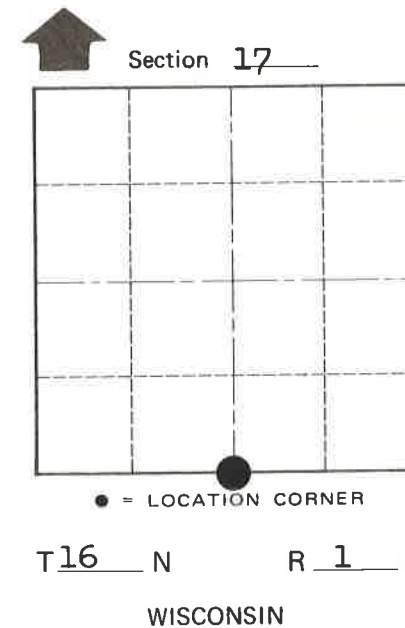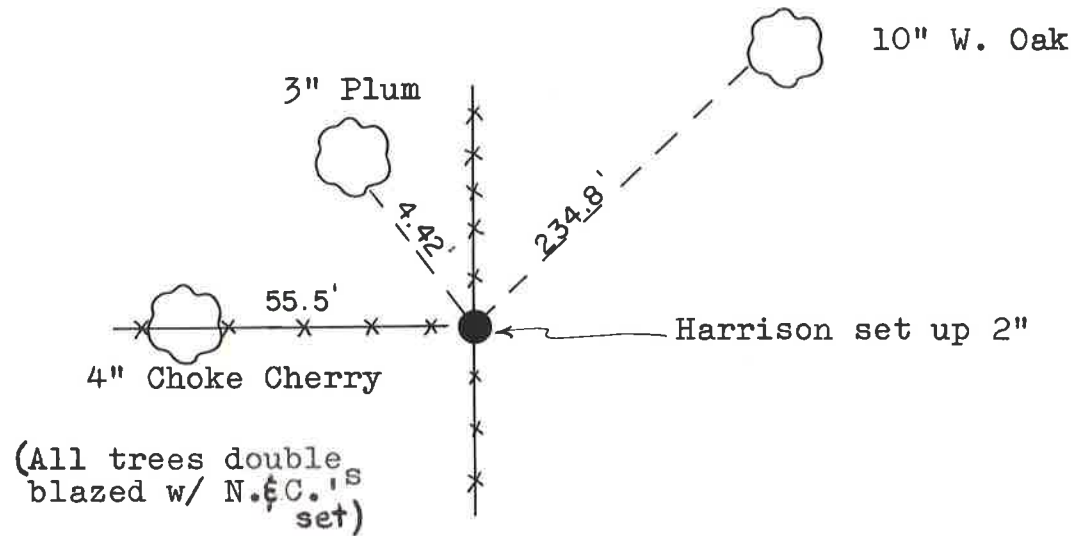

Approved: HARLEY A. SIME
MONROE CO. SURVEYOR

SURVEY CONTROL ORDER

Horizontal _____

Vertical _____

WISCONSIN COORDINATE SYSTEM

Corner	East (X)	North (Y)	Elevation (Z)	Zone
Control Sta. Name				

City, Village or Town Clifton

County of Monroe