

**U. S. Public Land Corner
Maintenance**

55 B

Corner: C1/4 Sec. 17, T16N-R1E

41601172020

<u>Date</u>	<u>Crew</u>	<u>Monument type</u>
June 13, 2022	Zachariah P. Dechant Gary L. Dechant	Found 1 1/4" round iron bar at new fence corner running north & east. U- channel steel post on south side, up 2'. 25' west of fence running south, 22' south of remnants of fence running east as per 1980 tie sheet. All 1980 BT's gone.

References:

	<u>Bearing</u>	<u>Distance</u>
1) Set 3/4"x24" round iron bar, 5' SW 14" Black Cherry	N52E	34.72'
2) Set 3/4"x24" round iron bar, 32' south & 3' west of fence corner east of C1/4	S32E	35.96'
3) Set 3/4" x24" round iron bar, 5' NE of 6" Red Oak	S50W	68.26'
4) Set 3/4"x24" round iron bar, 5' SE of 3" Red Oak, 8' west & 15' north of fence corner	N30W	17.53'

Compass bearings
Trees double blazed

Gary L. Dechant

June 13, 2022

41601172020

I, Harley A. Sime, do hereby certify that on the 27th day of March 1980, I found ~~(evidence)~~ (no evidence) of the C. 1/4 corner of Sec. 17, T16 N, R 1 E. Fourth Principal Meridian, and I re-established said corner according to the Wisconsin Statutes as shown and described hereon.

History of corner establishment since Original Government Survey
No known history since the original government survey.

Description of corner evidence found:

Set by intersecting the N-S, E-W quarter lines.

Dated this 8th day of April 1980.

Harley A. Sime R.L.S. 355

County Surveyor

See Reverse Side
For Maintenance



Description of corner and witness monuments, references and accessories used to perpetuate the original or re-established location of this corner:

Witnesses to corner location:

G. Dechant

G. Dade

T. Tormoen

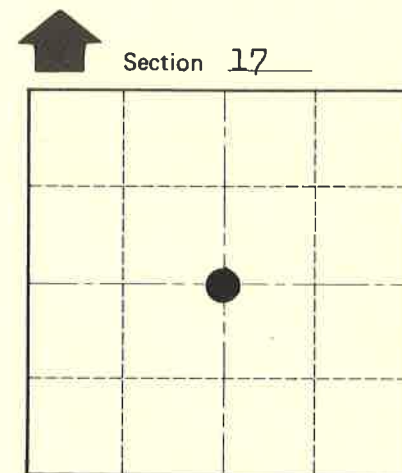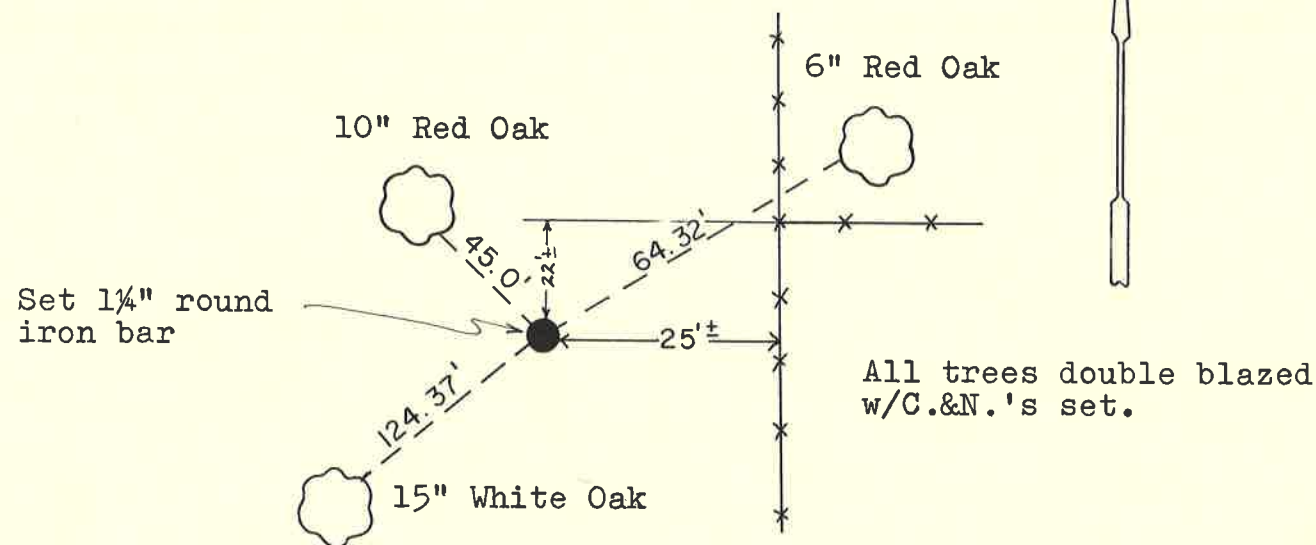

T 16 N R 1
WISCONSIN

Approved: **HARLEY A. SIME**
MONROE CO. SURVEYOR

SURVEY CONTROL ORDER

Horizontal	_____
Vertical	_____

WISCONSIN COORDINATE SYSTEM

Corner	East (X)	North (Y)	Elevation (Z)	Zone
Control Sta. Name				

City, Village or Town Clifton
County of Monroe

COUNTY SURVEYOR FORM NO. 1