

**U. S. Public Land Corner
Maintenance**

71

Corner: SW Sec. 17, T16N-R1E

41601180000

<u>Date</u>	<u>Crew</u>	<u>Monument type</u>
June 13, 2022	Zachariah P. Dechant Gary L. Dechant	Found Harrison intact at fence corner. Sign post on west side. Verified by 1980 BT.

<u>References:</u>	<u>Bearing</u>	<u>Distance</u>
1) Set 3/4"x24" round iron bar, 5' SW 12" Red Oak leaning NE	N58E	26.17'
2) Set 3/4"x24" round iron bar	S65E	22.87'
3) Set 3/4" x24" round iron bar in pasture	S47W	16.38'
4) Set 3/4"x24" round iron bar in pasture, 11' west of fence	N28W	28.09'

Compass bearings
Trees double blazed



I, Harley A. Sime, do hereby certify that on the 27th day of March 1980, I found (evidence) (~~no evidence~~) of the S.W. corner of Sec. 17, T 16 N, R 1 E, Fourth Principal Meridian, and I re-established said corner according to the Wisconsin Statutes as shown and described hereon.

Dated this 8th day of April 1980.

Harley A. Sime R.L.S. 335

County Surveyor
Title

History of original corner establishment:

D. Malliet set a 1 1/4" iron bar in a 3-way fence corner at this corner in May of 1978.

Description of corner evidence found:

Found an iron bar at a good 3-way fence corner and replaced it with a Harrison Monument.

**See Reverse Side
For Maintenance**

Description of corner and witness monuments, references and accessories used to perpetuate the original or re-established location of this corner:



Witnesses to corner location:

Gary Dechant

Chuck Dade

Tod Tormoen

No other ties in the area.

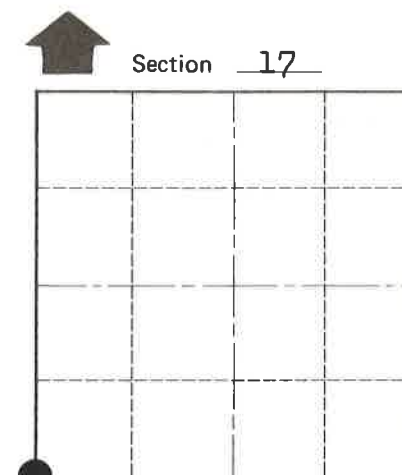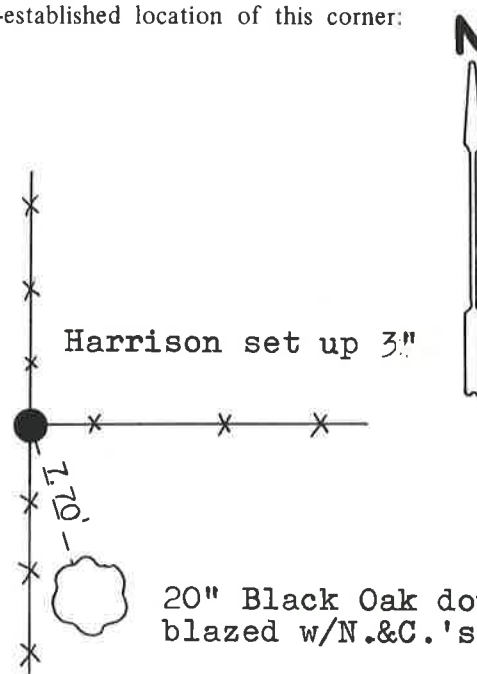

O = LOCATION CORNER

T 16 N R 1 E

WISCONSIN

**Approved: HARLEY A. SIME
MONROE CO. SURVEYOR**

SURVEY CONTROL ORDER

Horizontal	_____
Vertical	_____

WISCONSIN COORDINATE SYSTEM

Corner	East (X)	North (Y)	Elevation (Z)	Zone
Control Sta. Name				

City, Village or Town Clifton

County of Monroe

COUNTY SURVEYOR FORM NO. 1