

# U.S. Public Land Survey Monument Record


# 19

Corner ID: E 1/4 SEC. 2, T19N - R1E


41901022000

Type of Monument: SET 1/4" X 8' ROUND IRON BAR

SEC. 2, T19N - R1E

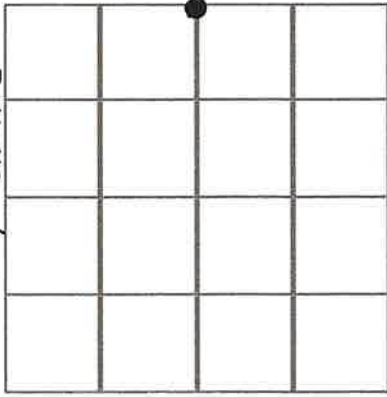

I certify that the U. S. Public Land Survey Monument Record is correct and complete to the best of my knowledge and belief.

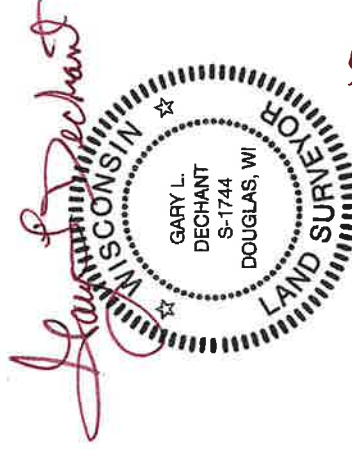

## County Coordinates:

Witnesses:  
Zachariah P. Dechant  
Al Hoff  
Gary L. Dechant

## Basis For Monument Location:

(Show info such as history, evidence, testimony, found or method of relocation)  
Original Government Survey corner established by George Cole in 1851.

No other known history since the original government survey.

We re-established this corner April 27, 2019.

Found no evidence of the corner. Set by single proportionate measurement. Fits Original distance north and south within inches.  
Revisited February 2, 2023, Ground Hog's Day, for coordinates.

