

# U.S. Public Land Survey Monument Record


# 57 B

Corner ID: 41801152020

C/4 SEC 15, T18N-R1E


Type of Monument:

I certify that the U. S. Public Land Survey Monument Record is correct and complete to the best of my knowledge and belief.

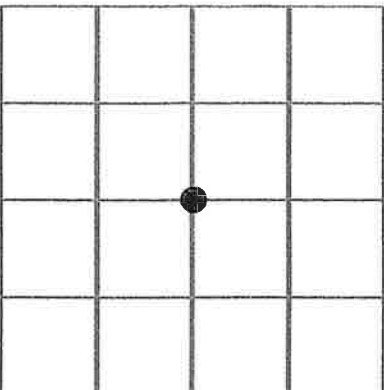

County Coordinates:

*Gary L. Dechant*  
GARY L. DECHANT  
FEBRUARY 14, 2023

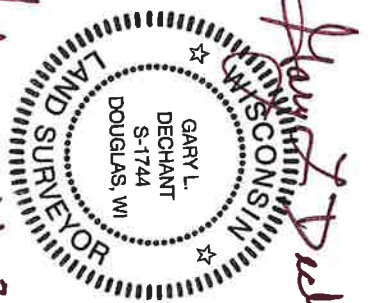

Witnesses: ZACHARIAN P. DECHANT

GARY L. DECHANT

Basis For Monument Location:

(Show info such as history, evidence, testimony, found or method of relocation)

BELIEVED TO HAVE BEEN SET BY HARLEY A SIMS & ASSOCIATES IN THE 1960'S. FOUND AND USED BY L. FERBERSEN IN 1970'S & 1981. FOUND AND ACCEPTED BY ME IN 1996 IN VOL. 11 CSM, P. 35, DEC. 452103.

O = SET 3/4" x 24" ROUND  
IRON BAR

COMPASS BEARINGS

