

U.S. PUBLIC LAND SURVEY MONUMENT RECORD

ROMPORTL #21504012000

HISTORY OF CORNER ESTABLISHMENT SINCE THE ORIGINAL GOVERNMENT SURVEY
SEE PREVIOUS TIE SHEET.

**SECTION 1, T15N, R4W
TOWN OF PORTLAND
MONROE COUNTY
WISCONSIN.**

DESCRIPTION OF CORNER EVIDENCE FOUND

FOUND AND ACCEPTED HARRISON MONUMENT AS SET BY GAROLD SIME AND TOOK NEW TIES AS SHOWN.



CREW/WITNESS FOR CORNER LOCATION
-CHRISTIAN J. RUNNING
-

FIELD WORK COMPLETED 9/07/2023

I, CHRISTIAN J. RUNNING RLS 2558, HEREBY CERTIFY THAT THE COORDINATES PROVIDED ON THIS RECORD WERE DETERMINED BY ME OR UNDER MY DIRECT SUPERVISION AND THAT THIS FORM IS CORRECT TO THE BEST OF MY KNOWLEDGE AND BELIEF.

CHRISTIAN J. RUNNING
PLS 2558
RUNNING LAND SURVEYING
700 DAUPHIN ST.
LA CROSSE, WI 54603

NOTE: ALL TIES ARE SET 3'± FROM FACE OF TREES. TREES ARE DOUBLE BLAZED.

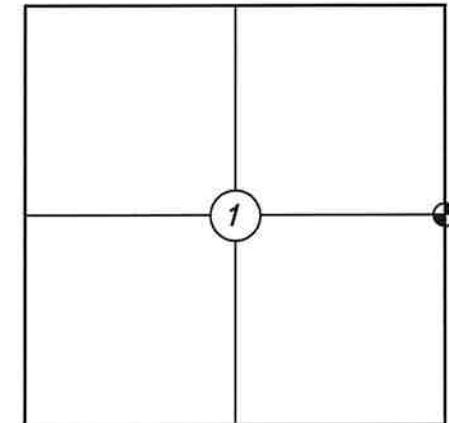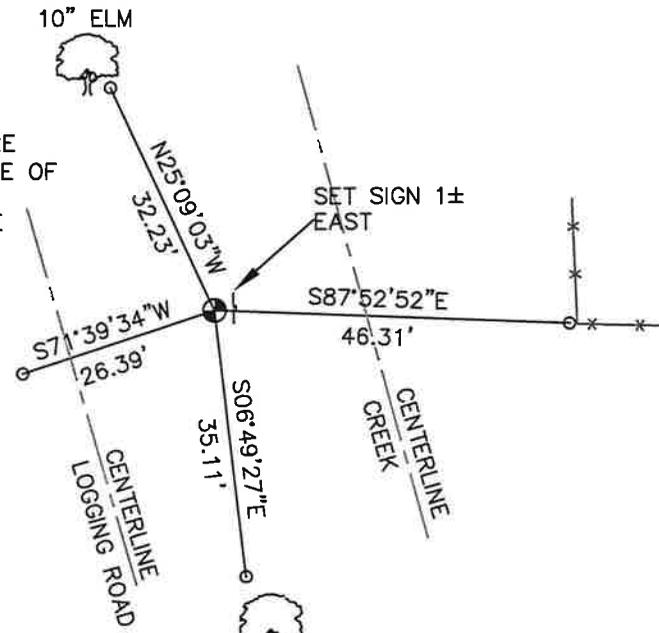

● CORNER LOCATION

LEGEND

- FOUND HARRISON
- SET 3/4" X 18" IRON BAR 1.5 LB/FT UNLESS NOTED

ALL BEARINGS ARE REFERENCED TO THE MONROE COUNTY COORDINATE SYSTEM NAD 83(2011)



MONROE COUNTY COORDINATES NAD 83(2011) NORTHING: 328930.3375 EASTING: 631465.7092

CERTIFICATE

CERTIFIED LAND CORNER

No. 14

21504012000

I, Garold A. Sime, do hereby certify that on the 27th day of July 1984, I found (evidence) (~~no evidence~~) of the W 1/4 corner of Section 6, T 15 N, R 3 W Fourth Principal Meridian, and I re-established said corner according to the Wisconsin Statutes as shown and described hereon.

Dated this 15th day of Oct. 1984.

Garold A. Sime

Garold A. Sime, R.L.S. 1261

Title

History of corner establishment since Original Government Survey

A.S. Ingalls was here in May of 1873
Fred Holden was here in April of 1903

Description of corner evidence found:

I accepted the fence corner as the best available evidence

COUNTY SURVEYOR FORM NO. 1

Description of corner and witness monuments, references and accessories used to perpetuate the original or re-established location of this corner:

Set Harrison Monument at corner

Witnesses to corner location:

G.A. Sime

Dallas Wilhite





SURVEY CONTROL ORDER

Horizontal _____

Vertical _____

WISCONSIN COORDINATE SYSTEM				
Corner	East (X)	North (Y)	Elevation (Z)	Zone
Control Sta. Name				

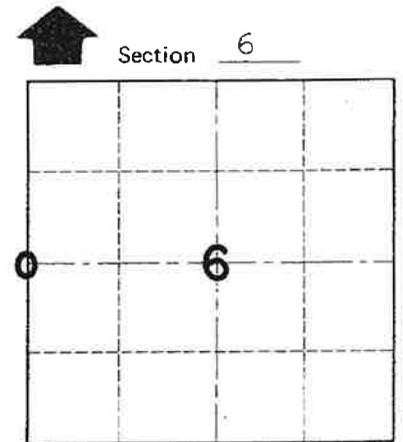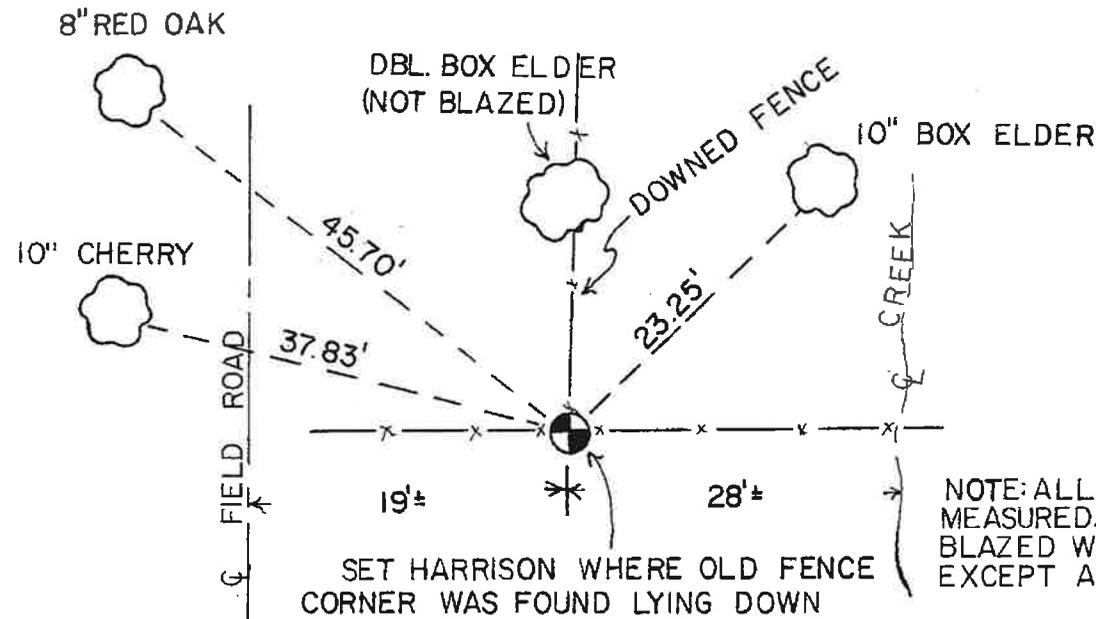

O = LOCATION CORNER

T 15 N R 3 W
WISCONSIN

NOTE: ALL DISTANCES SLOPE MEASURED. ALL TREES DOUBLE BLAZED WITH NAIL IN HACK, EXCEPT AS NOTED.

City, Village or Town Jefferson
County of Monroe