

U.S. PUBLIC LAND SURVEY MONUMENT RECORD

SECTION 29, T16N, R4W
TOWN OF LEON
MONROE COUNTY
WISCONSIN.

HISTORY OF CORNER ESTABLISHMENT SINCE THE ORIGINAL GOVERNMENT SURVEY
SEE PREVIOUS TIE SHEET.




DESCRIPTION OF CORNER EVIDENCE FOUND
FOUND AND ACCEPTED 1" IRON PIPE INSIDE A 2" IRON PIPE AS SET BY GARY DECHANT. TOOK NEW TIES AS SHOWN BELOW.

CREW/WITNESS FOR CORNER LOCATION
-CHRISTIAN J. RUNNING
-LEIGH A. RUNNING

FIELD WORK COMPLETED 3/07/2023

I, CHRISTIAN J. RUNNING RLS 2558, HEREBY CERTIFY THAT THE COORDINATES PROVIDED ON THIS RECORD WERE DETERMINED BY ME OR UNDER MY DIRECT SUPERVISION AND THAT THIS FORM IS CORRECT TO THE BEST OF MY KNOWLEDGE AND BELIEF.

CHRISTIAN J. RUNNING
PLS 2558
RUNNING LAND SURVEYING
700 DAUPHIN ST.
LA CROSSE, WI 54603

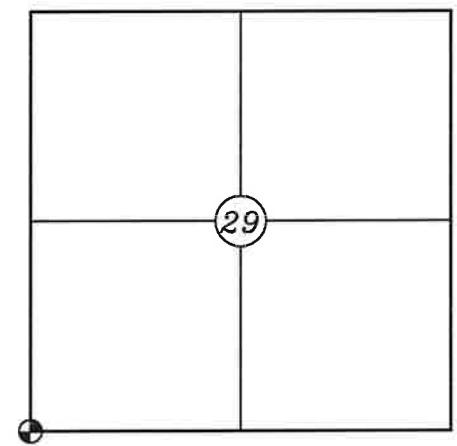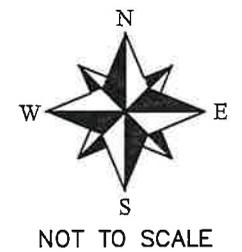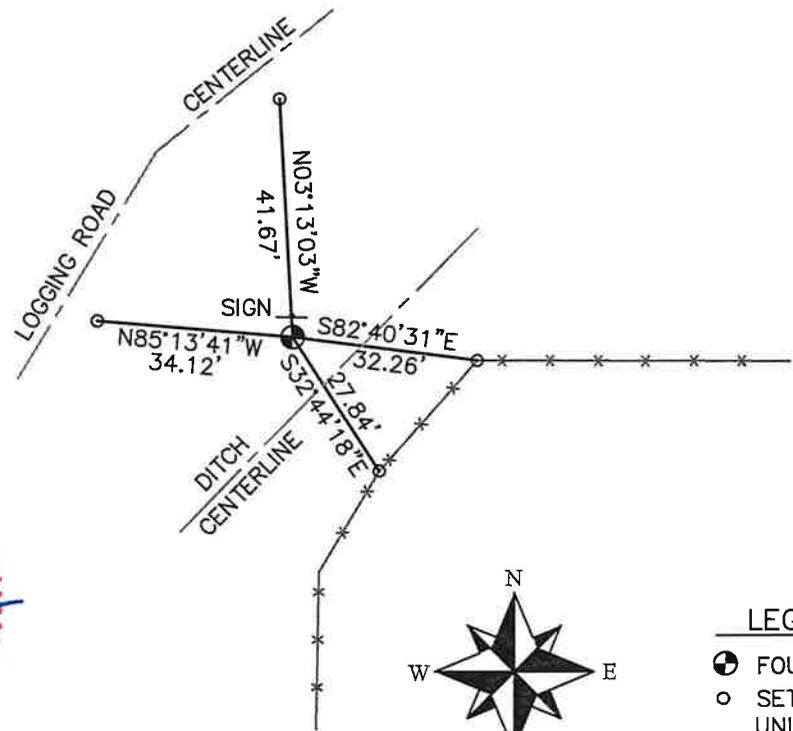

● CORNER LOCATION

LEGEND

- FOUND 1" IRON PIPE
- SET 3/4" X 18" IRON BAR 1.5 LB/FT UNLESS NOTED

ALL BEARINGS ARE REFERENCED TO THE MONROE COUNTY COORDINATE SYSTEM NAD 83(2011)

MONROE COUNTY COORDINATES NAD 83(2011)
NORTHING: 337037.2278
EASTING: 605325.5937

I, Gary L. Dechant, do hereby certify that on the 13th day of December 19 96, I found (evidence) (~~no evidence~~) of the SW corner of Section 29, T 16 N, R 4 W Fourth Principal Meridian, and I re-established said corner according to the Wisconsin Statutes as shown and described hereon.

Dated this 31st day of Dec. 19 96.

Gary L. Dechant
R.L.S. 1744

Title

History of corner establishment since Original Government Survey

O.R. Dahl was here in 1868.

Description of corner evidence found:

Set corner on line with the existing fence to the east and the projected north-south fence along the West line of the section. This corner location fits the occupied NW corner of the SW $\frac{1}{4}$ -SW $\frac{1}{4}$ and the SE corner of the SW $\frac{1}{4}$ -SW $\frac{1}{4}$ very well.

Distance from SW to W $\frac{1}{4}$ is about a chain short, could be largely due to terrain.

COUNTY SURVEYOR FORM NO. 1



Description of corner and witness monuments, references and accessories used to perpetuate the original or re-established location of this corner:

Witnesses to corner location:

David E. Madison

Gary L. Dechant

Gary L. Dechant
WISCONSIN
GARY L. DECHANT
S-1744
CAMP
DOUGLAS, WI
LAND SURVEYOR
December 31, 1996

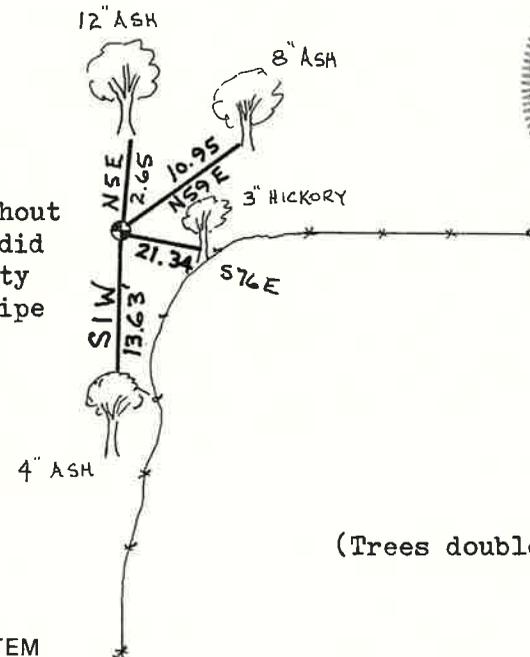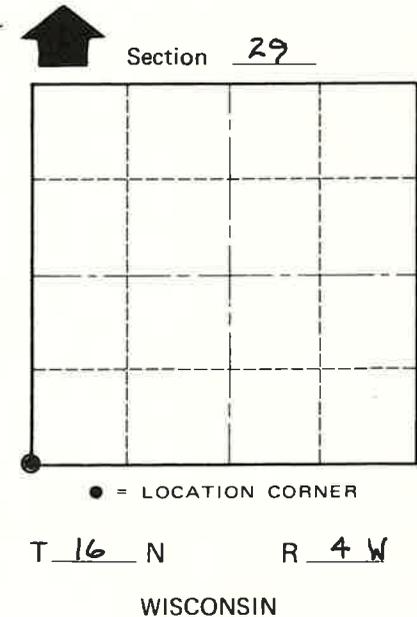

Corner falls in a deep washout (west edge of), therefore did not set 30" cast iron county marker, but 1" x 6' iron pipe inside 2"x24" iron pipe, set survey sign 1' north.

(Trees double blazed with 40d nails set)

SURVEY CONTROL ORDER

Horizontal	_____
Vertical	_____

WISCONSIN COORDINATE SYSTEM

Corner	East (X)	North (Y)	Elevation (Z)	Zone
Control Sta. Name				

City, Village or Town LEON
County of MONROE