

**U. S. Public Land Corner  
Maintenance**

# 125

Corner: SE Sec. 34, T17N-R2W

21702340000

<u>Date</u>	<u>Crew</u>	<u>Monument type</u>
August 10, 2023	Zachariah P. Dechant Gary L. Dechant	Found grader blade, up 4' being used as fence corner. Verified by 1977 bearing trees.

References:

- |  | <u>Bearing</u> | <u>Distance</u> |
|--|----------------|-----------------|
| 1) Set 5/8"x24" round rebar, 4'SW of 8"Hickory (1977 BT), 6' east of fence | N44E           | 12.12'          |
| 2) Set 5/8 "x24" round rebar, 4' NW of 7" Cedar                            | S10E           | 14.88'          |
| 3) Set 5/8"x24" round rebar, 4' NE of Cedar sapling, 10' south of fence    | S77W           | 38.17'          |
| 4) Set 5/8"x24" round rebar, 4' SE of 4' Maple, 6' west of fence           | N9W            | 20.40'          |

Compass bearings  
Trees double blazed



I, Harley A. Sime, do hereby certify that on the 21 day of October 1977, I found (evidence) ~~(no evidence)~~ of the Southeast corner of Section 34, T. 17 N, R. 2 W, Fourth Principal Meridian, and I re-established said corner according to the Wisconsin Statutes as shown and described hereon.

Dated this 1 day of Dec. 1977.

History of original corner establishment:

Hamilton La Rue was here in September 1897.

Description of corner evidence found:

Found existing grader blade up about 4', in a three way fence. Accepted this corner after traversing out the rest of the section.

Approved: **HARLEY A. SIME**

County Surveyor  
Title

**MONROE CO. SURVEYOR**

**See Reverse Side For Maintenance**


Description of corner and witness monuments, references and accessories used to perpetuate the original or re-established location of this corner:

Existing grader blade.


Witnesses to corner location:

Pietz

Dechant

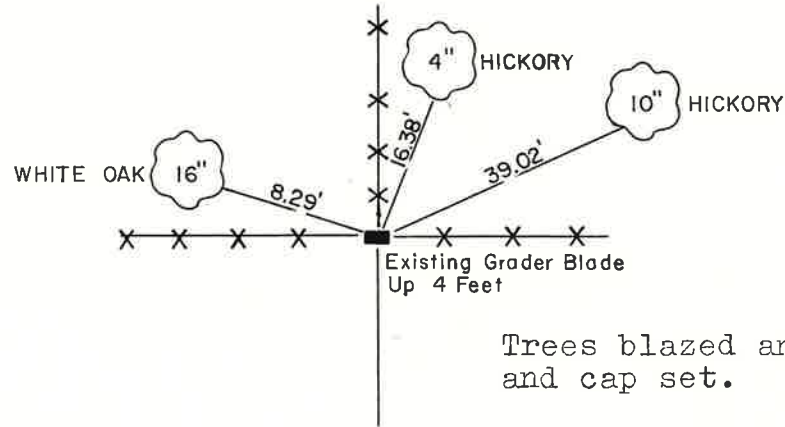

Trees blazed and nail and cap set.

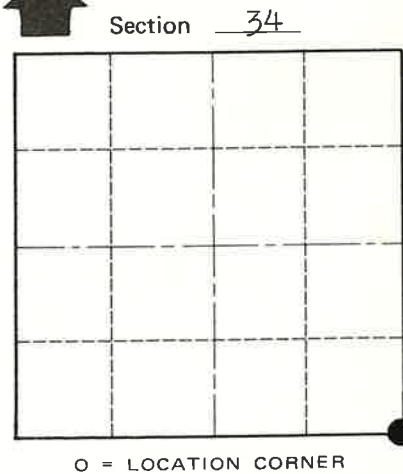

COUNTY SURVEYOR FORM NO. 1

SURVEY CONTROL ORDER

Horizontal	_____
Vertical	_____

WISCONSIN COORDINATE SYSTEM

Corner	East (X)	North (Y)	Elevation (Z)	Zone
Control Sta. Name				

City, Village or Town Adrian

County of Monroe  
Wisconsin