

U.S. PUBLIC LAND SURVEY MONUMENT RECORD

ROMPORTL #21603080000

HISTORY OF CORNER ESTABLISHMENT SINCE THE ORIGINAL GOVERNMENT SURVEY
SEE PREVIOUS TIE SHEET.

*SECTION 8, T16N, R3W,
TOWN OF WELLS
MONROE COUNTY
WISCONSIN.*




DESCRIPTION OF CORNER EVIDENCE FOUND
FOUND AND ACCEPTED HARRISON MONUMENT AS SET BY RON PARISH, VERIFIED EXISTING TIES AND TOOK NEW TIES AS SHOWN.

CREW/WITNESS FOR CORNER LOCATION
-CHRISTIAN J. RUNNING
-

FIELD WORK COMPLETED 10/6/2023

I, CHRISTIAN J. RUNNING RLS 2558, HEREBY CERTIFY THAT THE COORDINATES PROVIDED ON THIS RECORD WERE DETERMINED BY ME OR UNDER MY DIRECT SUPERVISION AND THAT THIS FORM IS CORRECT TO THE BEST OF MY KNOWLEDGE AND BELIEF.

CHRISTIAN J. RUNNING
PLS 2558
RUNNING LAND SURVEYING
700 DAUPHIN ST.
LA CROSSE, WI 54603

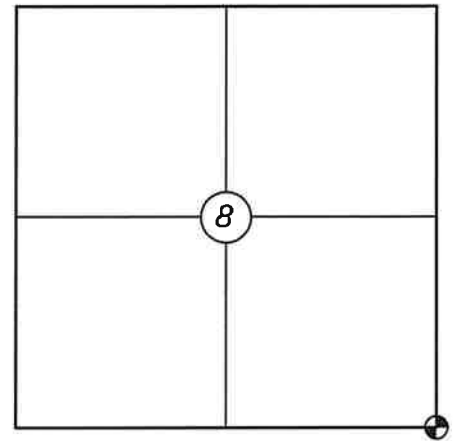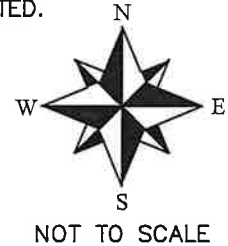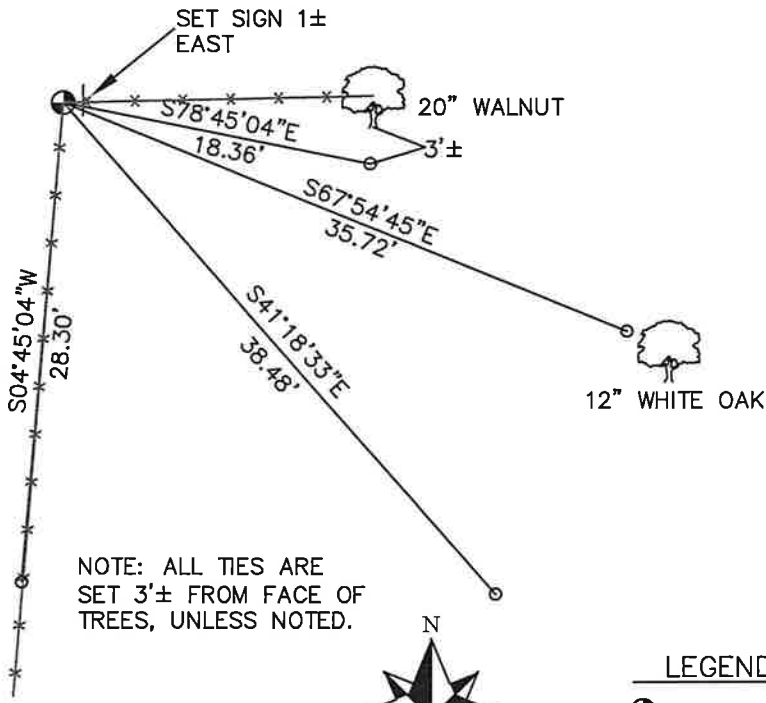

⊕ CORNER LOCATION

LEGEND

- ⊕ FOUND HARRISON MONUMENT
- SET 3/4" X 18" IRON BAR 1.5 LB/FT UNLESS NOTED

ALL BEARINGS ARE REFERENCED TO THE MONROE COUNTY COORDINATE SYSTEM NAD 83(2011)

MONROE COUNTY COORDINATES NAD 83(2011)
NORTHING: 353026.9564
EASTING: 642209.7854

I, Ronald D. Parish, do hereby certify that on the 28th day of August 1987, I found (evidence) (no evidence) of the NW corner of Section 16, T 16 N, R 3 W. Fourth Principal Meridian, and I re-established said corner according to the Wisconsin Statutes as shown and described hereon.

Dated this 4th day of Sept. 1987.

Ronald Parish
Ronald D. Parish
Registered Land Surveyor
Title

History of corner establishment since Original Government Survey
No known history since the Original Government Survey.

Description of corner evidence found:

Found no evidence of corner. Set corner at a two-way fence corner as the best available evidence.

Description of corner and witness monuments, references and accessories used to perpetuate the original or re-established location of this corner:




Witnesses to corner location:

Ronald D. Parish

Robert Sherwood



All trees double blazed with a nail and cap in one blaze.

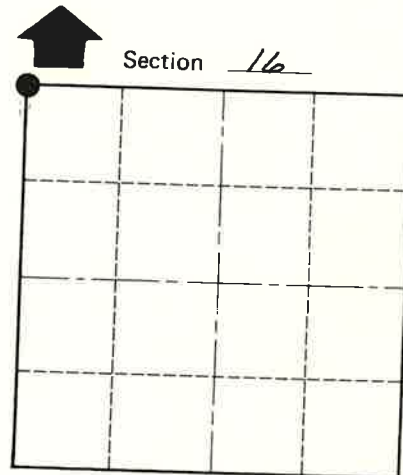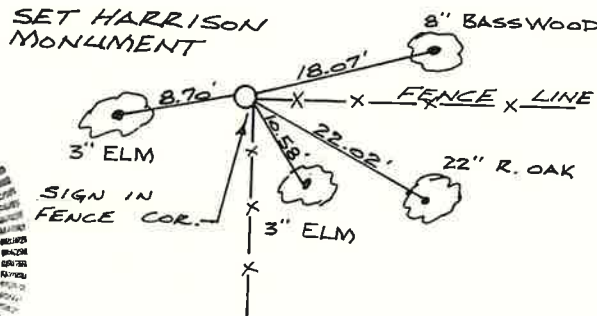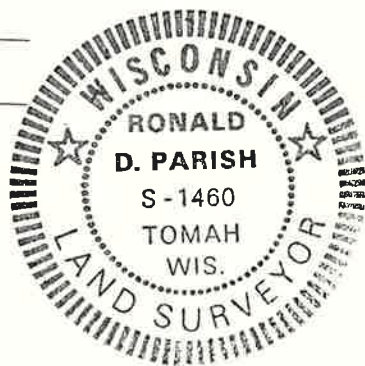

• = LOCATION CORNER

T 16 N R 3 W

WISCONSIN

COUNTY SURVEYOR FORM NO. 1

SURVEY CONTROL ORDER

Horizontal _____

Vertical _____

WISCONSIN COORDINATE SYSTEM				
Corner	East (X)	North (Y)	Elevation (Z)	Zone
Control Sta. Name				

City, Village or Town Wells

County of Monroe