

**U. S. Public Land Corner  
Maintenance**

# 26

Corner: S1/4 Sec. 3, T15N-R1E

41501030020

Date Crew Monument type

November 15, 2023 Al Hoff  
Gary L. Dechant

Found Harrison in field, down 16"

References:

- 1) Set 5/8"x24" round rebar, down 12" in field
- 2) Set 5/8"x24" round rebar, down 12" in field
- 3) Set 5/8"x24" round rebar, down 12" in field
- 4) Set 5/8"x24" round rebar, down 12" in field

<u>Bearing</u>	<u>Distance</u>
N81°05'02"E	30.58'
S5°19'03"W	29.70'
S88°17'05"W	29.05'
N10°49'16"W	25.45'



Monroe County Coordinate System

41501030020

I, Harley A. Sime, do hereby certify that on the 28<sup>th</sup> day of July 19 81, I found ~~(no evidence)~~ (no evidence) of the South 1/4 corner of Section 3, T 15 N, R 1 E Fourth Principal Meridian, and I re-established said corner according to the Wisconsin Statutes as shown and described hereon.

History of corner establishment since Original Government Survey

No known recorded history since the original government survey.

Description of corner evidence found:

Set by single proportionate measurement.

Dated this 4<sup>th</sup> day of August 1981.

Harley A. Sime, R.L.S. 355

County Surveyor

Title

See Reverse Side For Maintenance

COUNTY SURVEYOR FORM NO. 1


Description of corner and witness monuments, references and accessories used to perpetuate the original or re-established location of this corner:

Witnesses to corner location:


Dechant

Meyer

OPEN

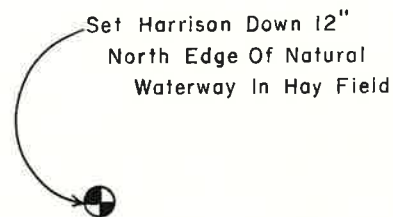

FIELD

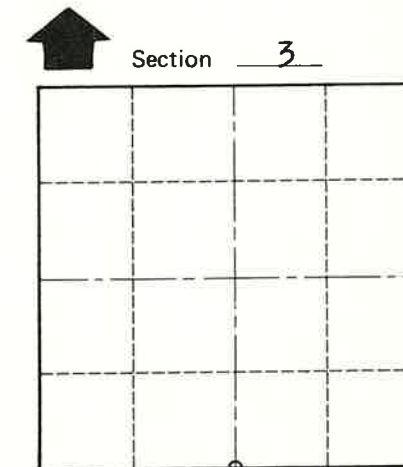

O = LOCATION CORNER

T 15 N R 1 E

WISCONSIN

Approved: **HARLEY A. SIME**  
**MONROE CO. SURVEYOR**

SURVEY CONTROL ORDER

Horizontal	_____
Vertical	_____

WISCONSIN COORDINATE SYSTEM

Corner	East (X)	North (Y)	Elevation (Z)	Zone
Control Sta. Name				

~~City/Village~~ Town Glendale  
County of Monroe  
Wisconsin