

U. S. Public Land Corner Maintenance

17

Corner: E1/4 Sec. 4, T15N-R1E

41501042000

Date	Crew	Monument type
November 15, 2023	Al Hoff Gary L. Dechant	Found 1" round iron bar in field, down 14" Harrison apparently was destroyed and replaced with iron bar, approx. 42' south of fence

References:

- 1) Set 5/8"x24" round rebar, 2' south of fence
- 2) Set 5/8"x24" round rebar, down 10" in field
- 3) Set 5/8"x24" round rebar, north edge of trail/field road
- 4) Set 5/8"x24" round rebar, 2' south of fence

Bearing	Distance
N26°06'51"E	50.04'
S6°30'20"W	24.35'
N75°15'42"W	40.67'
N3°36'40"W	41.74'



Monroe County Coordinate System

41501042000

I, Harley A. Sime, do hereby certify that on the 28th day of July 1981, I found ~~(evidence)~~ (no evidence) of the West 1/4 corner of Section 3, T 15 N, R 1 E Fourth Principal Meridian, and I re-established said corner according to the Wisconsin Statutes as shown and described hereon.

History of corner establishment since Original Government Survey

No known recorded history since the original government survey.

Description of corner evidence found:

Set by single proportionate measurement.

See Reverse Side For Maintenance

Dated this 4th day of August 1981.

Harley A. Sime, R.L.S. 355

County Surveyor
Title

COUNTY SURVEYOR FORM NO. 1



Description of corner and witness monuments, references and accessories used to perpetuate the original or re-established location of this corner:

Witnesses to corner location:

Dechant

Meyer

NOTE: All Distances Are Slope Distances
Trees Double Blazed With Nails Set

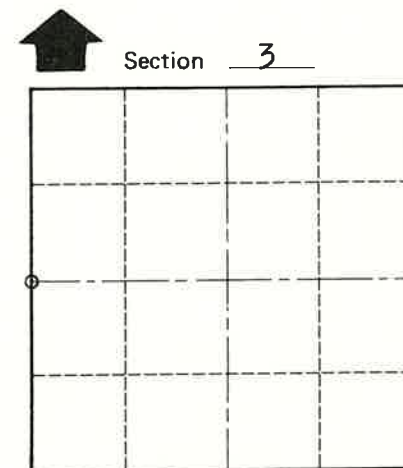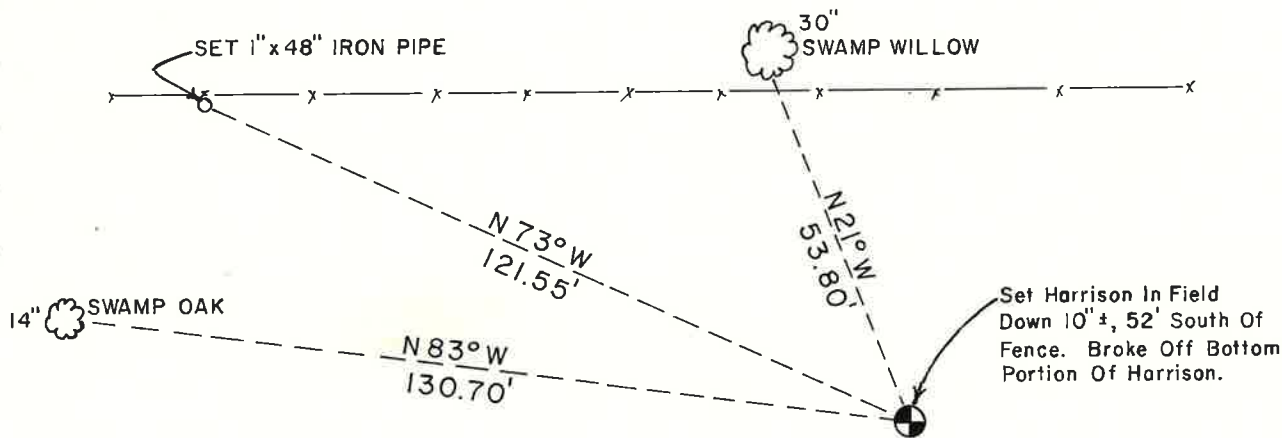

O = LOCATION CORNER

T 15 N R 1 E

WISCONSIN

Approved: **HARLEY A. SIME**
MONROE CO. SURVEYOR

SURVEY CONTROL ORDER

Horizontal	_____
Vertical	_____

WISCONSIN COORDINATE SYSTEM

Corner	East (X)	North (Y)	Elevation (Z)	Zone
Control Sta. Name				

~~City, Village or~~ Town Glendale
County of Monroe
Wisconsin