

**U. S. Public Land Corner  
Maintenance**

# 117

Corner: W1/4 Sec. 34, T16N-R1E

41601332000

<u>Date</u>	<u>Crew</u>	<u>Monument type</u>
January 3, 2024	Zachariah P. Dechant Gary L. Dechant	Found Harrison intact, 3' north of east-west fence, sign 1/2' south

1) Set 5/8"x24" round rebar, down 12" in field, 19' north of fence	<u>Bearing</u>	<u>Distance</u>
2) Set 5/8"x24" round rebar, down 6" in pasture, 24' south of fence	N32E	22.69'
3) Set 5/8"x24" round rebar, down 6" in pasture, 16' south of fence	S17E	25.77'
4) Set 5/8"x24" round rebar, down 12" in field, 20' north of fence	S30W	21.94'
	N36W	21.17'



Compass bearings

I, Harley A. Sime, do hereby certify that on the 28<sup>th</sup> day of July 19 81, I found ~~evidence~~ (no evidence) of the West 1/4 corner of Section 34, T 16 N, R 1 E Fourth Principal Meridian, and I re-established said corner according to the Wisconsin Statutes as shown and described hereon.

Dated this 4<sup>th</sup> day of August 1981.

Harley A. Sime, R.L.S. 355

County Surveyor  
Title

History of corner establishment since Original Government Survey

No known recoded history since the original government survey.

Description of corner evidence found:

Set by single proportionate measurement.

**See Reverse Side For Maintenance**



COUNTY SURVEYOR FORM NO. 1

Description of corner and witness monuments, references and accessories used to perpetuate the original or re-established location of this corner:

Witnesses to corner location:

Dechant

Meyer

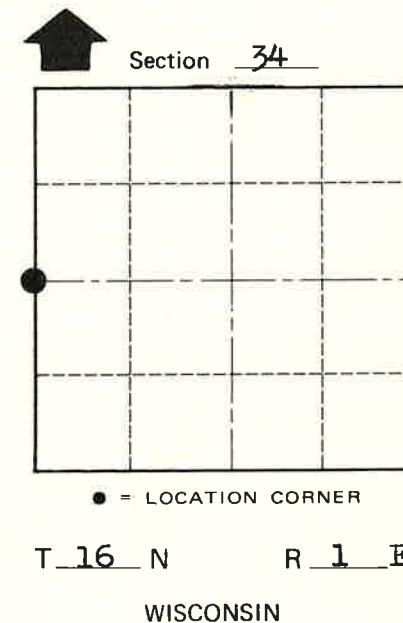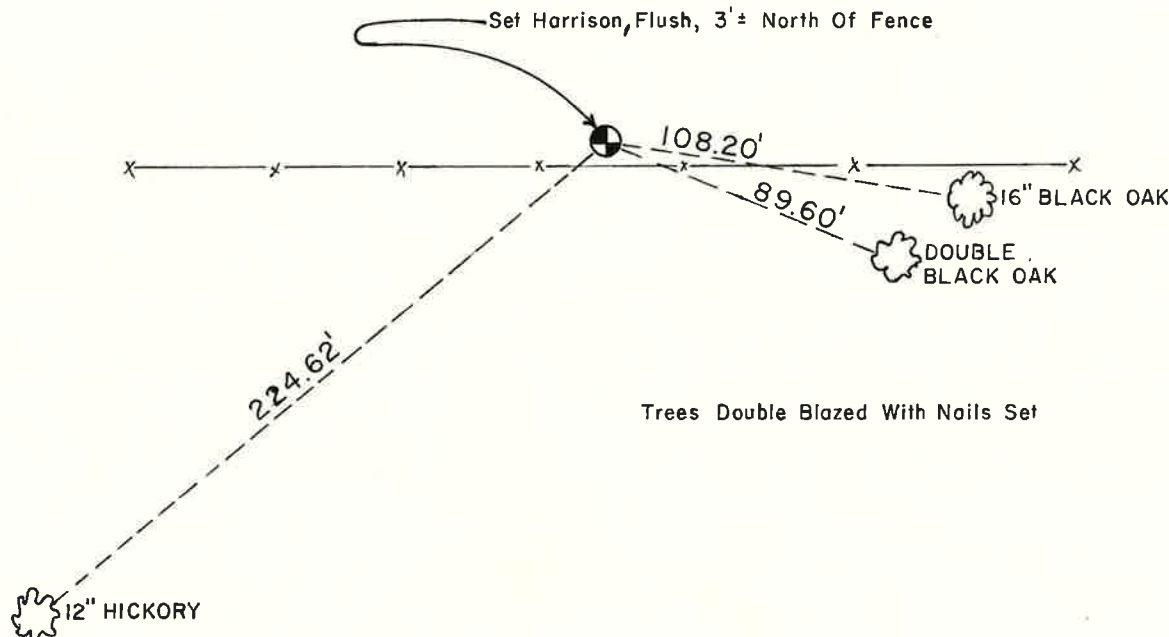

**Approved: HARLEY A. SIME**  
**MONROE CO. SURVEYOR**

SURVEY CONTROL ORDER

Horizontal	_____
Vertical	_____

WISCONSIN COORDINATE SYSTEM

Corner	East (X)	North (Y)	Elevation (Z)	Zone
Control Sta. Name				

~~City, Village or~~ Town Clifton  
County of Monroe  
Wisconsin