

U. S. Public Land Corner Maintenance

21

Corner: SE Sec. 1, T16N-R1W

21601010000

<u>Date</u>	<u>Crew</u>	<u>Monument type</u>
February 26, 2024	Zachariah P. Dechant Gary L. Dechant	Found 2½" round iron bar on steep south slope, stones around bar, sign 2' east, falls 23' south & 4' west of present fence corner. Bar is up 3'. Tried to drive it in further but on solid rock.
1) Set 5/8"x24" rebar, south side of rock outcrop		<u>Bearing</u> <u>Distance</u>
2) Set 5/8"x24" rebar, north side of 1.5'x2' stone		N49E 9.37'
3) Set 5/8"x24" rebar 1' west of large stone with 1987 chiseled cross on face		N72E 18.93'
4) Set 5/8"x24" rebar, in center of 18' diameter rock		N76E 48.00'
5) Found PK nail and washer on rock ledge (1987 tie)		S38E 35.81'
		N89W 27.00 (26.90')

Compass bearings



I, Gary L. Dechant, do hereby certify that on the 30th day of September 19 87, I found ~~(evidence)~~ (no evidence) of the SE corner of Section 1, T 16 N, R 1 W Fourth Principal Meridian, and I re-established said corner according to the Wisconsin Statutes as shown and described hereon.

Dated this 6th day of Oct. 19 87.

Gary L. Dechant

Registered Land Surveyor, 1744
Title

History of corner establishment since Original Government Survey

No known recorded history since the original government survey. U.S.G.S. map shows a corner here, but was almost certain to have been dug out because of the gravel pit now surrounding it (gravel pit abandoned).

Description of corner evidence found:

Set at the intersection of lines formed between the SW and S $\frac{1}{4}$ corners of Section 1 and between the E $\frac{1}{4}$ Section 1 and the E $\frac{1}{4}$ corner of Section 12. This location fits segment of fence found approx. 600'+ west of this corner very well. The half mile distances along the south line of Section 1 are also very close to being equal using this computed location for the SE of Section 1, and the same for the East line of Section 1.

Description of corner and witness monuments, references and accessories used to perpetuate the original or re-established location of this corner:

See Reverse Side For Maintenance

Witnesses to corner location:

David E. Madison

Gary L. Dechant

ROCK OUTCROP
2nd LEDGE
DOWN

NAIL & CAP

26.90'
S 89° W

31.26'
S 38° E


50.19'
N 76° E

CHISELLED ON
STONE FACE



Set 2 $\frac{1}{2}$ "x7' iron bar on south slope, 23.5 feet south of top of hill. Layered flat shale stone around iron bar. Sign placed 23.5' North (Top Hill)

NAIL & CAP IN
OUTCROP
18' DIA.

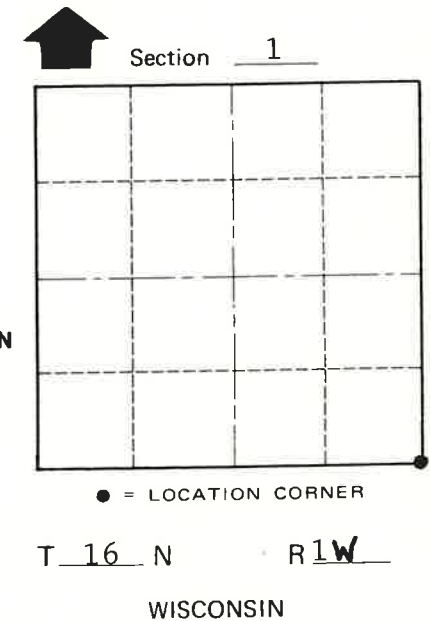

• = LOCATION CORNER

T 16 N R 1 W
WISCONSIN

SURVEY CONTROL ORDER

Horizontal	_____
Vertical	_____

WISCONSIN COORDINATE SYSTEM

Corner	East (X)	North (Y)	Elevation (Z)	Zone
Control Sta. Name				

City/Village/Town Wilton
County of Monroe

COUNTY SURVEYOR FORM NO. 1