

**U.S. PUBLIC LAND CORNER  
MAINTENANCE**

# 76


Corner ID: E1/4 Sec. 20, T17N-R1W  
21701202000

<u>DATE</u>	<u>CREW</u>	<u>MONUMENT INFO</u>
March 15, 2024	Zachariah P. Dechant Gary L. Dechant	Found Harrison, top broke off at fence corner running east and south

- 1) Set 5/8"x24" round rebar, down 12" in field
- 2) Set 5/8"x24" round rebar, 5' NW of 19" White Oak
- 3) Set 5/8"x24" round rebar
- 4) Set 5/8"x24" round rebar, down 12" in field

Compass bearings  
Trees double blazed

<u>Bearing</u>	<u>Distance</u>
N53E	20.24'
S67E	28.99'
S58E	13.45'
N51W	30.84'

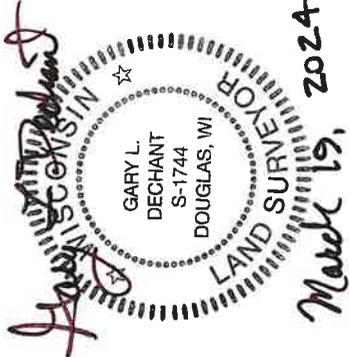

I, Bryan H. Meyer, do hereby certify that on the 4th day of December 1986, I found (evidence) ~~no evidence~~ of the East  $\frac{1}{4}$  corner of Section 20, T 17 N, R 1 W Fourth Principal Meridian, and I re-established said corner according to the Wisconsin Statutes as shown and described hereon.

Dated this 22nd day of Dec. 1986.

Bryan H. Meyer  
Deputy County Surveyor  
Title

History of corner establishment since Original Government Survey

Nothing recorded.

Description of corner evidence found:

I accepted a three-way fence corner as the best available evidence.

**See Reverse Side  
For Maintenance**



COUNTY SURVEYOR FORM NO. 1

Description of corner and witness monuments, references and accessories used to perpetuate the original or re-established location of this corner:

Crew: Meyer, Kenworthy  
Date: December 4, 1986 - 1:30 P.M.  
Weather: Windy, Clear, 15°±  
Witnesses to corner location:

Bryan H. Meyer

John "Rory" Kenworthy


Set  $\frac{3}{4}$ "x24" iron bar



Set standard cast iron Harrison marker at fence corner, up 2"±.

NOTE: The three trees shown are double blazed; each distance shown is to a nail set in a hack in the side of each tree; the bearings shown are magnetic hand compass bearings; the 12" white oak and the 16" black oak are scribed in the upper blaze.

WISCONSIN COORDINATE SYSTEM

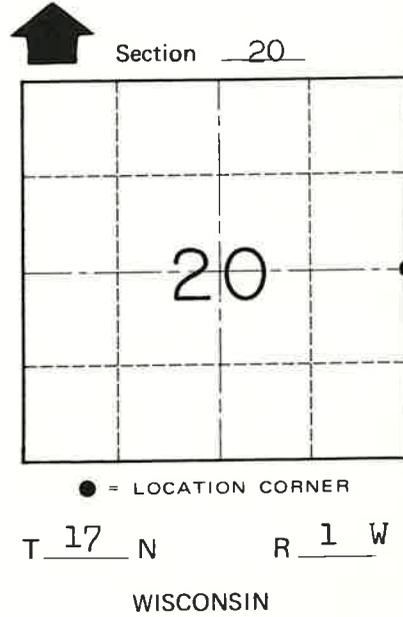

SURVEY CONTROL ORDER

Horizontal	_____
Vertical	_____

Corner	East (X)	North (Y)	Elevation (Z)	Zone
Control Sta. Name				

~~City Village or~~ Town of Tomah  
County of Monroe