

U. S. Public Land Corner Maintenance

#102

Corner: S1/4 Sec. 25, T18N-R2W

21802250020

<u>Date</u>	<u>Crew</u>	<u>Monument type</u>
March 20, 2024	Zachariah P. Dechant Gary L. Dechant	Found Harrison intact at remnants of 3- way fence corner, sign on west side

- 1) Set 5/8"x24" rebar
- 2) Set 5/8"x24" rebar
- 3) Set 5/8"x24" rebar, 4' NE of 18" triple Maple
- 4) Set 5/8"x24" rebar

Trees double blazed
Compass bearings

Gary L. Dechant



March 25, 2024

<u>Bearing</u>	<u>Distance</u>
N55W	13.94'
S7W	26.78'
S40W	14.62'
N87W	27.61'

I, Harley A. Sime, do hereby certify that on the _____ day of October 19 74, I found (evidence) (~~no evidence~~) of the S 1/4 corner of Section 25, T 18 N, R 2 W Fourth Principal Meridian, and I re-established said corner according to the Wisconsin Statutes as shown and described hereon.

History of original corner establishment:

Description of corner evidence found:

Dated this 23rd day of Nov. 1977.

Intersected fence corners, Harrison up 3".

Harley Sime
County Surveyor
Title

Approved: HARLEY A. SIME
MONROE CO. SURVEYOR



See Reverse Side For Maintenance

COUNTY SURVEYOR FORM NO. 1

Description of corner and witness monuments, references and accessories used to perpetuate the original or re-established location of this corner:

Witnesses to corner location:

K. Pritzlaff
D. Malliet

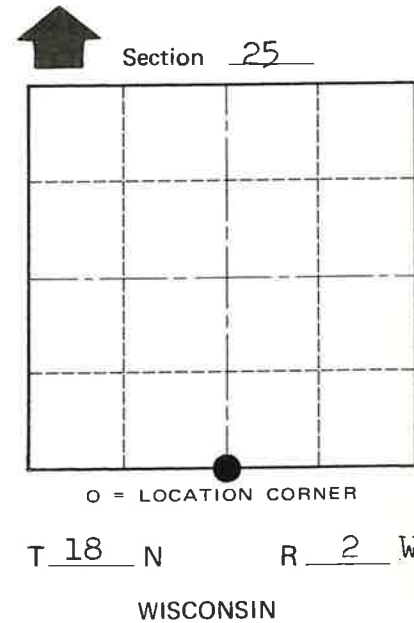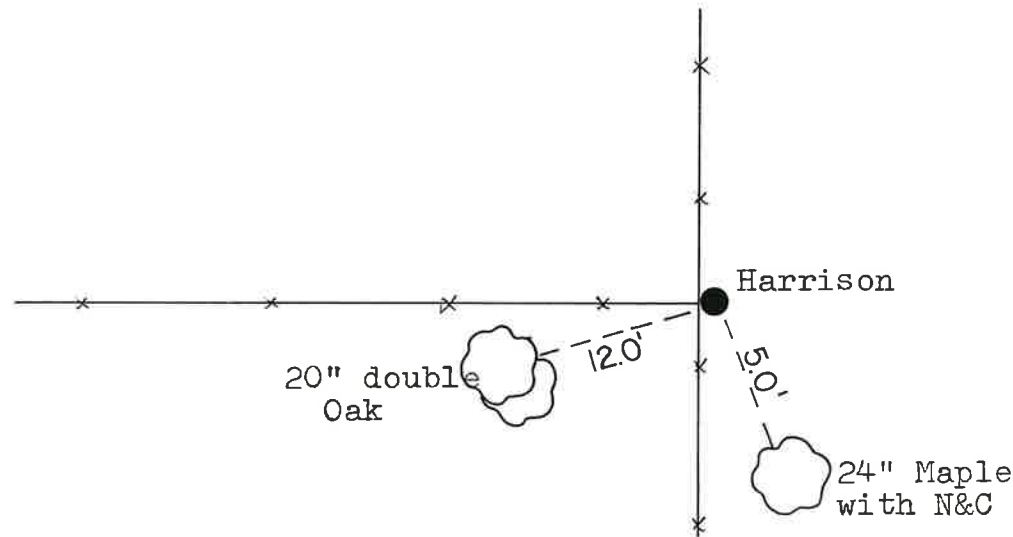

SURVEY CONTROL ORDER

Horizontal	_____
Vertical	_____

WISCONSIN COORDINATE SYSTEM

Corner	East (X)	North (Y)	Elevation (Z)	Zone
Control Sta. Name				

City, Village or Town Greenfield
County of Monroe