


U. S. Public Land Corner Maintenance

56

Corner: W1/4 Sec. 16, T16N-R1E

41601172000

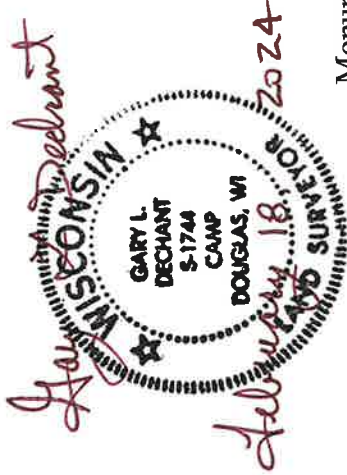

| <u>Date</u> | <u>Crew</u> | <u>Monument type</u> |
|------------------|---|--|
| February 7, 2024 | Zachariah P. Dechant Gary L. Dechant | Found Harrison intact at fence corner. Sign post west side and a sign post 1' NW |

- 1) Set 5/8"x24" iron rebar, 12' east of fence
- 2) Set 5/8"x24" iron rebar
- 3) Set 5/8"x24" iron rebar, 4' NE of 6" Hickory, 25' south of fence
- 4) Set 5/8"x24" round rebar, 4" SE of 3" Hickory

| <u>Bearing</u> | <u>Distance</u> |
|----------------|-----------------|
| N57E | 21.76' |
| S74E | 26.77' |
| S78W | 57.65' |
| NW | 30.93 |

Compass bearings
Set stones over rebars

I, HARLEY A. SIME, do hereby certify that on the 26TH day of FEBRUARY 1980, I found ~~(evidence)~~ (no evidence) of the W 1/4 corner of SECTION 16, T 16 N, R 1E Fourth Principal Meridian, and I re-established said corner according to the Wisconsin Statutes as shown and described hereon.

History of corner establishment since Original Government Survey
 No known history since the original government survey.

Dated this 12th day of MARCH 1980.

Description of corner evidence found:

The corner was set equidistant between section corners and in the N-S fence line.

HARLEY A. SIME R.L.S. 335

See Reverse Side For Maintenance

COUNTY SURVEYOR
Title



COUNTY SURVEYOR FORM NO. 1

Description of corner and witness monuments, references and accessories used to perpetuate the original or re-established location of this corner:

Witnesses to corner location:

G. DECHANT

T. TORMOEN

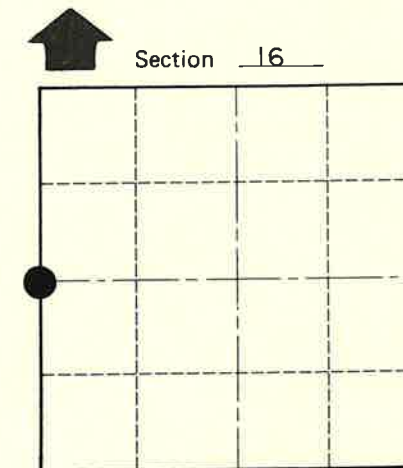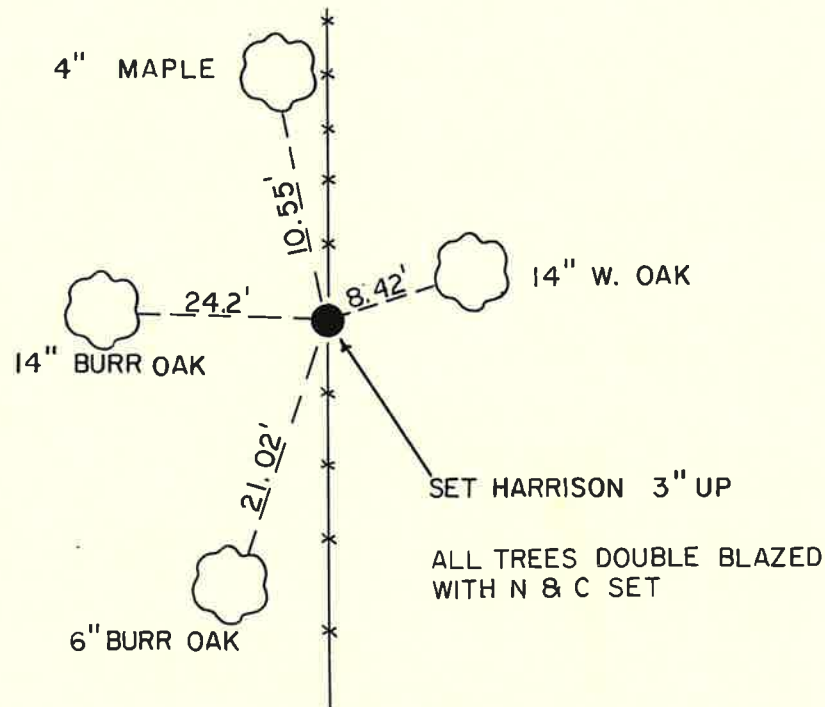

• = LOCATION CORNER

T 16 N R 1E

WISCONSIN

Approved: HARLEY A. SIME
MONROE CO. SURVEYOR

SURVEY CONTROL ORDER

| | |
|------------|-------|
| Horizontal | _____ |
| Vertical | _____ |

WISCONSIN COORDINATE SYSTEM

| Corner | East (X) | North (Y) | Elevation (Z) | Zone |
|-------------------|----------|-----------|---------------|------|
| Control Sta. Name | | | | |

City, Village or Town CLIFTON

County of MONROE