

U. S. Public Land Corner Maintenance

107

Corner: NW Sec. 34, T16N-R1E

41601280000

Date	Crew	Monument type
February 2, 2024	Zachariah P. Dechant Gary L. Dechant	Found Harrison at three way fence corner, sign 1' north, verified by 1981 bearing trees
1) Set 5/8"x24" rebar, 5' SW of 16" Burr Oak (1981 BT), 4' north of fence		Bearing Distance N68E 20.77'
2) Set 5/8"x24" rebar, 9' south of fence		S69E 18.85'
3) Set 5/8"x24" rebar, 4' NE of 3" Black Cherry, 6' south of fence		S68W 12.13'
4) Set 5/8"x24" rebar, 7' SE of 24" Black Oak		N30W 34.44'

Compass bearings

Bearing trees double blazed



I, Harley A. Sime, do hereby certify that on the 28th day of July 19 81, I found (evidence) ~~(no evidence)~~ of the Northwest corner of Section 34, T 16 N, R 1 E Fourth Principal Meridian, and I re-established said corner according to the Wisconsin Statutes as shown and described hereon.

Dated this 4th day of August 19 81.

Harley A. Sime, R.L.S. 355

County Surveyor
Title

History of corner establishment since Original Government Survey

No known recorded history since the original government survey.

Description of corner evidence found:

Accepted fence corner as best available evidence. It fits other field evidence well.

See Reverse Side For Maintenance

COUNTY SURVEYOR FORM NO. 1

Description of corner and witness monuments, references and accessories used to perpetuate the original or re-established location of this corner:

Witnesses to corner location:

Dechant



Meyer

Betthausen Bros.

**Approved: HARLEY A. SIME
MONROE CO. SURVEYOR**

SURVEY CONTROL ORDER

Horizontal	_____
Vertical	_____

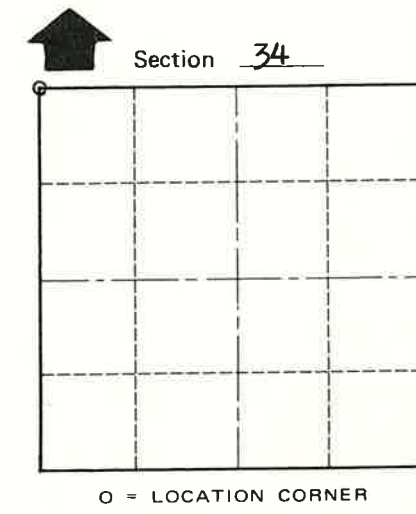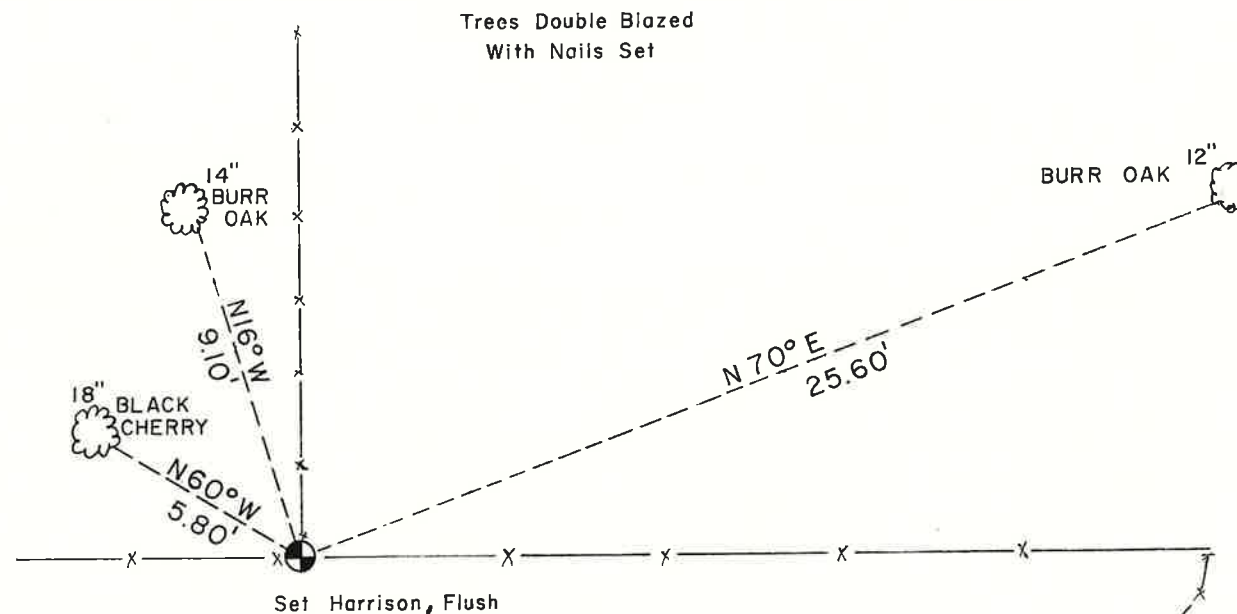

WISCONSIN COORDINATE SYSTEM

Corner	East (X)	North (Y)	Elevation (Z)	Zone
Control Sta. Name				

~~City Village or~~ Town Clifton
County of Monroe
Wisconsin