



41601320000

I, Harley A. Sime, do hereby certify that on the 31 day of July 1981, I found (evidence) ~~(no evidence)~~ of the Northwest corner of Section 4, T15 N, R 1 E Fourth Principal Meridian, and I re-established said corner according to the Wisconsin Statutes as shown and described hereon.

Dated this 4th day of August 1981.

Harley A. Sime, R.L.S. 355

County Surveyor

Title

History of corner establishment since Original Government Survey

G. Sime set a 3/4" iron bar here in 1976.

Description of corner evidence found:

Found G. Sime's iron bar and replaced it with a Harrison Monument. Accepted the fence corner as the best available evidence of the original government corner.

**See Reverse Side For Maintenance**



Description of corner and witness monuments, references and accessories used to perpetuate the original or re-established location of this corner:

Trees Double Blazed With Nail Set

Witnesses to corner location:

Dechant

Meyer

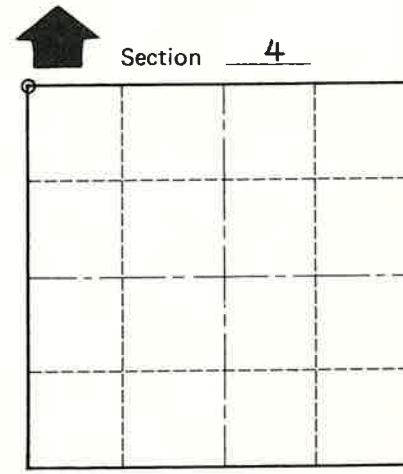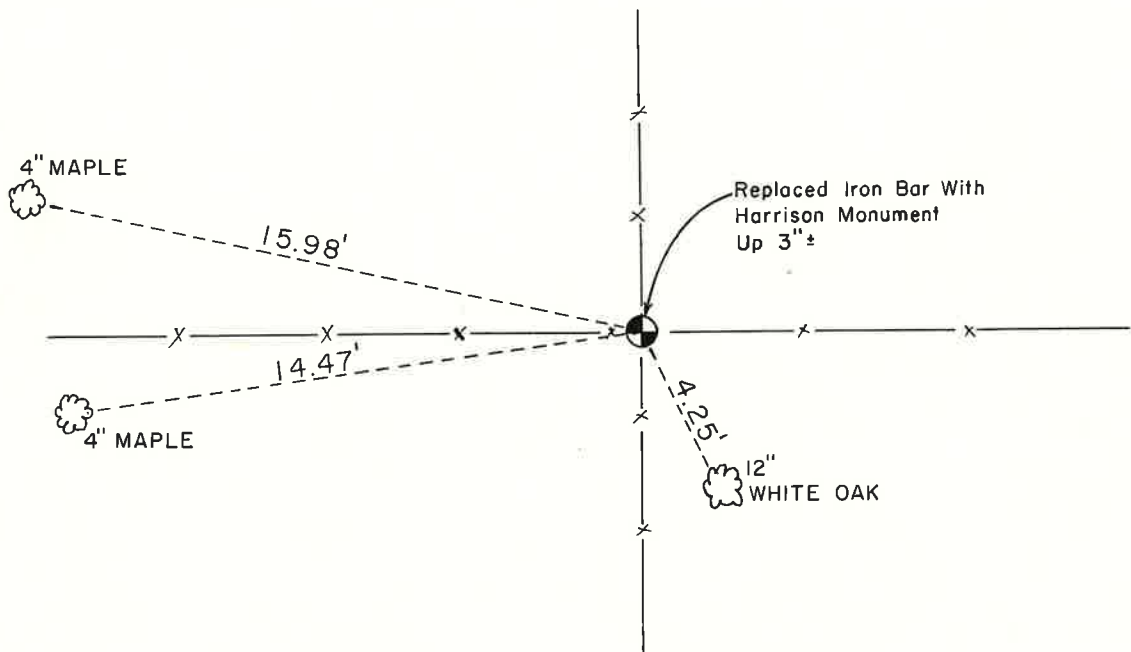

O = LOCATION CORNER

T 15 N R 1 E

WISCONSIN

**Approved: HARLEY A. SIME  
MONROE CO. SURVEYOR**

SURVEY CONTROL ORDER

Horizontal	_____
Vertical	_____

WISCONSIN COORDINATE SYSTEM

Corner	East (X)	North (Y)	Elevation (Z)	Zone
Control Sta. Name				

~~City Village or~~ Town Glendale

County of Monroe

Wisconsin

COUNTY SURVEYOR FORM NO. 1