

# U. S. Public Land Corner Maintenance

# 123

Corner: SE Sec. 35, T16N-R1E

41601350000



Date	Crew	Monument type
February 9, 2024	Zachariah P. Dechant Gary L. Dechant	Found Harrison intact at remnants of fence corner.

- 1) Set 1"x24" iron pipe
- 2) Set 3/4"x24" round bar, 6' west of 16" Hickory (1981 BT)
- 3) Set 1"x24" iron pipe 7' NW of 13" Box Elder
- 4) Set 5/8"x24" round rebar, 3' NE of 6" Black Cherry

Compass bearings

Trees double blazed

Bearing	Distance
N31E	10.95'
N81E	13.02'
S41E	45.62'
S7W	38.58'

I, Harley A. Sime, do hereby certify that on the 31st day of July 1981 I found (evidence) ~~(no evidence)~~ of the SE corner of Section 35, T 16 N, R 1 E Fourth Principal Meridian, and I re-established said corner according to the Wisconsin Statutes as shown and described hereon.

Dated this 7th day of August 1981.

Harley A. Sime, R.L.S. 355

County Surveyor

Title

History of corner establishment since Original Government Survey

O. R. Dahl was here in December of 1870.

Description of corner evidence found:

Accepted fence corner as best available evidence. It also fits other field evidence well.

**See Reverse Side For Maintenance**



Description of corner and witness monuments, references and accessories used to perpetuate the original or re-established location of this corner:

Witnesses to corner location:

G. Dechant

B. Meyer

Trees Double Blazed  
With Nails Set

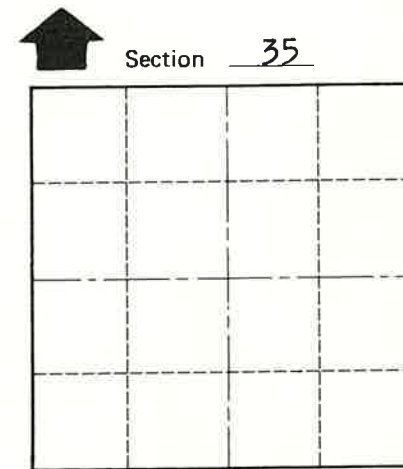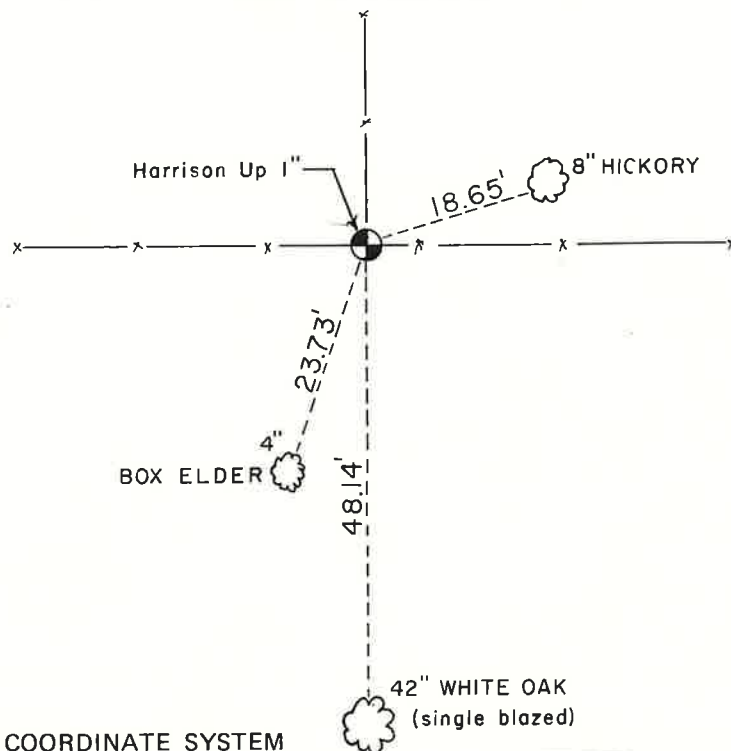

O = LOCATION CORNER  
T 16 N R 1 E  
WISCONSIN

**Approved: HARLEY A. SIME**  
**MONROE CO. SURVEYOR**

SURVEY CONTROL ORDER

Horizontal	_____
Vertical	_____

WISCONSIN COORDINATE SYSTEM

Corner	East (X)	North (Y)	Elevation (Z)	Zone
Control Sta. Name				

~~City Village or~~ Town Clifton  
County of Monroe

COUNTY SURVEYOR FORM NO. 1