

U. S. Public Land Corner Maintenance

119

Corner: E1/4 Sec. 35, T16N-R1E

41601352000

Date	Crew	Monument type
February 7, 2024	Zachariah P. Dechant Gary L. Dechant	Found Harrison, top broke off, in trail, on line with fence north and east, down 6"
1) Set 5/8"x24" iron rebar		<u>Bearing</u> <u>Distance</u>
2) Set 5/8"x24" iron rebar, 19' south of fence		N20E 30.52'
3) Set 5/8"x24" iron rebar, down 8" in trail		S79E 50.00'
4) Set 5/8"x24" round rebar		S39W 28.48'
		N13W 30.13'



Compass bearings

I, Harley A. Sime, do hereby certify that on the 30th day of July 1981, I found (evidence) (~~no evidence~~) of the E 1/4 corner of Section 35, T 16 N, R 1 E Fourth Principal Meridian, and I re-established said corner according to the Wisconsin Statutes as shown and described hereon.

Dated this 5th day of August 1981.

Harley A. Sime, R.L.S. 355

County Surveyor

History of corner establishment since Original Government Survey

O. R. Dahl was here in December of 1870.

Description of corner evidence found:

Accepted fence corner as best available evidence as it fits other field evidence well.

See Reverse Side For Maintenance

COUNTY SURVEYOR FORM NO. 1



Description of corner and witness monuments, references and accessories used to perpetuate the original or re-established location of this corner:

Witnesses to corner location:

G. Dechant

C. Pietz

B. Meyer

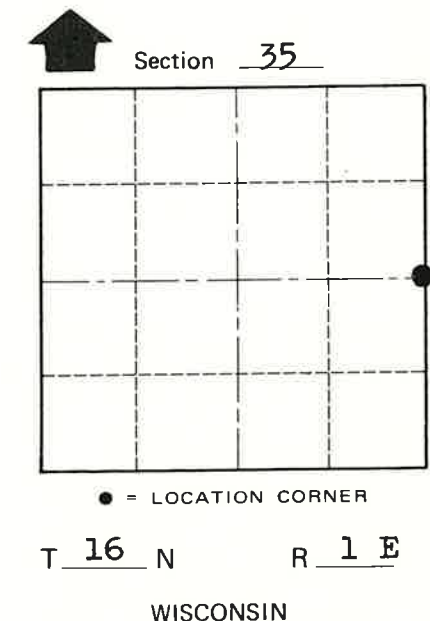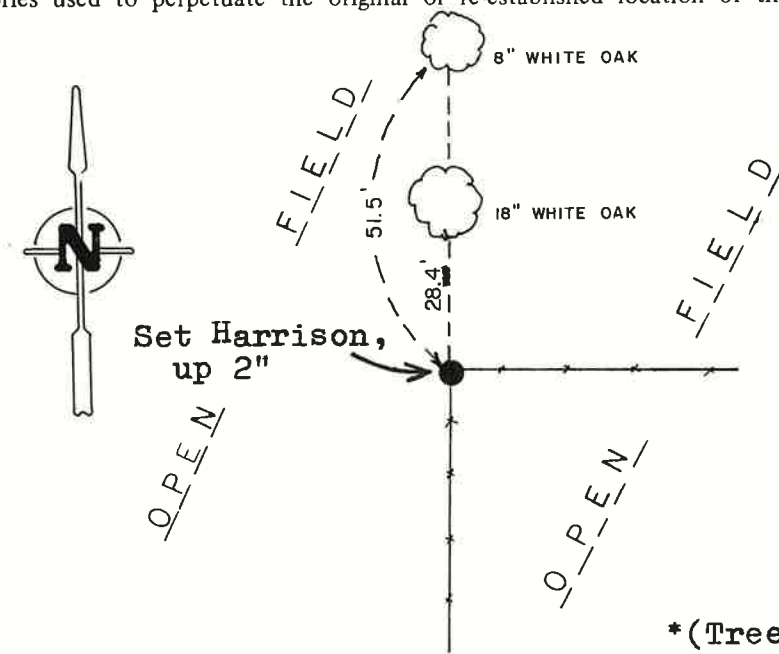

Approved: **HARLEY A. SIME**
MONROE CO. SURVEYOR

SURVEY CONTROL ORDER

Horizontal	_____
Vertical	_____

WISCONSIN COORDINATE SYSTEM

Corner	East (X)	North (Y)	Elevation (Z)	Zone
Control Sta. Name				

(Trees double blazed with nails set)

~~City, Village of~~ Town Clifton
County of Monroe