


and the 8 Sticks on the  $\frac{1}{2}$  Line on the S of the  $\frac{1}{2}$  Sec: and also at equal distances from the 8 Sticks on the East side of the Sec: to the corresponding 8 Sticks on the  $\frac{1}{2}$  Line between the Centre and the  $\frac{1}{2}$  Stick on the N side. The N & S & West Lines were run with 8° Variations. The topography of the ground was carefully taken notice of and the Chainman was sworn according to Law.

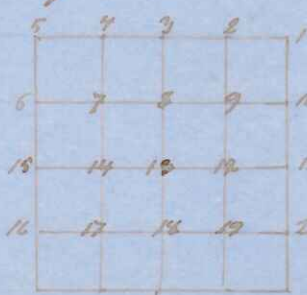

Remarks

- 1 Pt at 1 Tamarac 4' N 75° W 122. 900 A 9 destroyed but the Post found.
- 2 " " 5 Tamarac 5 N 50 1/2 E 48 900 A 8 destroyed
- 3 " " 6 Tamarac 5 N 35 1/2 W 95 & W Pine 14 S 65 1/2 E 174
- 4 " " 7 Poplar 3 N 13 1/2 W 85
- 5 " " 8 R Oak 12 E 14. & R Oak 4 N 16 1/2 W 72
- 6 " " 9 R Oak 4 N 41 1/2 W 110 no other tree near
- 7 " " 11 P Oak 12 N 61 W 405 1/2 900 A 8 destroyed
- 8 " " 12 Maple 5 S 11 1/2 W 40 & dry Tamarac 14 N 53 1/2 W 95
- 9 " " 13 W Oak 18 N 71 1/2 E 107 no other tree near
- 10 " " 14 R Oak N 33 1/2 101
- 11 " " 17 W Birch 5 N 63 1/2 26 & W Oak 8 S 69 1/2 E 42
- 12 " " 18 R Oak 6 N 41 1/2 W 67 & Tamarac 6 N 20 1/2 E 55.

Mr. Dahl  
County Surveyor

As it remembered that on the 17<sup>th</sup> day of December 1885 I was surveying the SE  $\frac{1}{4}$  of Sec: 19 Town 15 Range 1 East and also the W  $\frac{1}{2}$  of NW  $\frac{1}{4}$  of Sec: 20 except 5 acres on the SE corner of the SW  $\frac{1}{4}$  of NW  $\frac{1}{4}$  of Sec: 20 also 17 acres on the West side of the NW  $\frac{1}{4}$  of SW  $\frac{1}{4}$  Sec: 20. 15 East and so by request of the owner of the same Mr. McFlane and proceeded on follow to wit Commenced at the  $\frac{1}{2}$  Stick on the South side of the Sec: thence N 80° W 5 Links to the  $\frac{1}{2}$  Stick on the N side of the Sec: thence the  $\frac{1}{2}$  Stick in the Centre of the Sec: was established on a straight Line and at equal distances between the 2 quarter Sticks; thence a straight Line was established from the  $\frac{1}{2}$  Stick on the Centre to that on the  $\frac{1}{2}$  Sec: on the East side of the Sec: thence the 8 Sticks on the  $\frac{1}{2}$  Line were established at equal distances from the  $\frac{1}{2}$  Stick on the Centre and that on the ~~the SE corner of the~~ <sup>the S side of the</sup> Sec: thence East from said 8 Sticks 34 Rods to a Stick with A 9. thence N 20° W to a Stick on the Sec: Line thence West