


34 Rods to the  $\frac{1}{2}$  Plek between Sec: 17 & 20. Thence the distance from the East mountain  $\frac{1}{2}$  Plek to that on the East side of Sec 20 was carefully measured and found to contain 80 Ch 24 Links and the  $\frac{1}{2}$  Plek on the line and the 8 Pleks was then established at equal distances Thence the distance from the Corner of Sec: 17 18 19 & 20 to the  $\frac{1}{2}$  Plek between Sec: 17 & 20 was measured and found to contain 40 Ch 37 Links and the 8 Plek on the line was established at equal distances. Meridian on the N & S Line  $9^{\circ}$  and on the E & W Line  $11^{\circ}$  4 Rods 1 Chain was used. The Chainman sworn according to Law.

Remarks

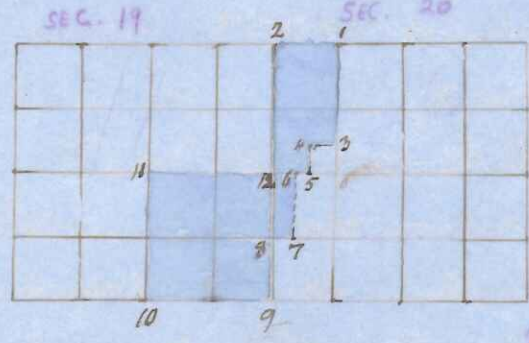

- 13 Stat 1 Henry 8 576 & 208 W Oak 15 519 W 19
- 5 " 2 R Oak 14 N 49 1/2 W 20 & R Oak 20 S 39 1/2 E 40
- 26 " 3 Henry 8 537 & 208 & Henry 10 N 55 W 12
- 27 " 4 S Maple 12 S 77 1/2 E 34.
- 28 " 5 W Oak 12 N 77 W 22
- 29 " 6 R Oak 10 N 52 1/2 W 27
- 30 " 7 Henry 8 N 21 E 17. R Oak 14 S 62 W 24
- 16 " 8 W Oak 15 S 58 E 33 & Aspen 10 S 74 W 29
- 25 " 9 W Oak 15 N 64 E 27 & W Oak 20 S 20 W 31.
- " 10 R Oak 15 N 54 E 11 & R Oak 12 S 18 E 50
- " 11 W Oak 15 S 55 1/2 W 23 & Henry 8 N 28 W 9.
- 15 " 12 W Oak 20 S 65 W 18 & W Oak 20 S 60 E 22

I hereby certify that the proceedings on record on stated  
 O. R. Dahl

As it is remembered that on the 18<sup>th</sup> day of Dec: 1868 I was surveying the  $\frac{1}{2}$  of NW  $\frac{1}{4}$  and the W  $\frac{1}{2}$  of NE  $\frac{1}{4}$ . 5 Acres on the SE Corner of SW  $\frac{1}{4}$  of NW  $\frac{1}{4}$  and 23 Acres on East side of NW  $\frac{1}{4}$  of SW  $\frac{1}{4}$  Sec: 20. Town 15 Range 1 East by request of the owner of the same Mr J G Backers and proceeded as follows to wit. Commenced at the Corner of Sec 17, 18, 19 & 20. 15. 12 Thence the distance from here to the  $\frac{1}{2}$  Plek between Sec: 17 & 20 was carefully measured and found to contain 40 Ch 37 L Thence the 8 Plek on the line was established at equal distances between this 2 points. Thence the distance from said  $\frac{1}{2}$  Plek to the NE Corner of the Sec: was found to contain 39 Ch 50 Links and Thence the 8 Plek was established at equal distance between Thence the distance from the  $\frac{1}{2}$  Plek on the West side of the Sec: was found to contain 80 Ch 24 L.