



The: three N to the 4 Stake on the ^{West} North side distance
 80 Ch: 53 Links three the 4 Stake on the center of the Sec:
 was estab: equal distance between them and also the 8
 stake on the Sec was estab: at equal distance between
 the 4 Stake on the center and that on the East side
 than the distance between the 4 Stake on the North side and
 the NE corner of the Sec: was carefully measured and
 found to contain 40 Ch 14 Links and the 8 Stake on this
 line estab: at equal distance between them
 4 Rods & chain was used the chain was
 sworn according to Gov: Vows also on the
 N & S, E & W Lines &c.

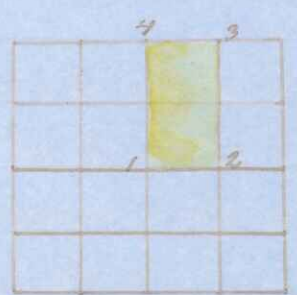

- Remarks
- 13. B T at 1 W Oak 20 N 2 E 34 & W Oak 5 N 44 W 57.
 - 12. " " 2 W Oak 6 N 40 W. 19.
 - 9. " " 3 B Oak 2 S 36 W 20 & W Oak 2 N 35 E 34
 - 3. " " 4 B Oak 14 N 30 E & 185 no other tree near

I hereby certify that the proceedings are correct as stated
 O R Duke

He it remembered that on the 2nd day of
 January 1869 I was surveying the N & S of N & E of
 Sec: 29. 15. 4 W by request of the owner of the same
 Mr: Hans Halvorsen and proceeded as follows to wit
 After the 4 Stake on the center of the Sec: was established
 at equal distance from the N & S, E & W 4 Stake the
 distance between the NE corner to the 4 Stake on the N
 side was measured and the 8 Stake on this line estab: at
 equal distance between them than the distance be-
 tween the NE corner and the 4 Stake on the East side was
 measured and found to contain 40 Ch: 14 Links and the 8 stake
 on the Sec: established at equal distance than the dist
 from the 8 Stake East of the Center 4 Stake to the 8 Stake East of
 the 4 Stake on the N side was measured and the 8 Stake on the
 center of the N & S estab: at equal distance from the
 N & S, E & W side of the 4 Stake.

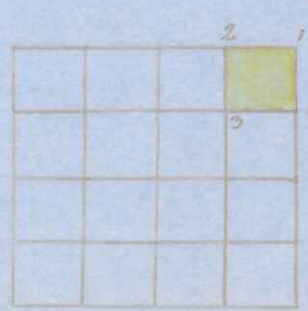

- Remarks
- 4. B T at 1 W Oak 9 N 53 W 16 & W Oak 6 N 40 E 24
 - 2. " " 3 W Oak 2 N 45 W 20 & W Oak 2 N 35 E 39
 - 9. " " 2 W Oak 24 N 59 E 60 & W Oak 20 N 49 W 56
 - 10. " " 4 W Oak 8 N 79 E 72 & W Oak 14 N 45 W 75.