


4 Rods Chain was used Variation on the N & S  
 E & W Line 8° The Chainman was sworn according  
 to Law: I hereby certify that the proceedings are correct as  
 stated

O. B. Danks

Be it remembered that on the 2<sup>nd</sup> day of  
 January 1869 I was surveying the S & E of N & E of  
 Sec: 29. T. 15. R. 4 West by request of the owner of the  
 same Mr. Hans Savelsteen and proceeded as follows  
 to wit: Commenced at the 7<sup>th</sup> Stake on the center of the  
 Sec: thence the distance from here to the 7<sup>th</sup> Stake on  
 the East side was measured and found to contain  
 40 Ch: 19 Links and the 8<sup>th</sup> Stake on the same side: at equal dis-  
 tances between them, the distance from the 7<sup>th</sup> Stake on  
 the East side to that on the N.E. Corner of the Sec:  
 was found to contain 40 Ch: 14 Links and the 8<sup>th</sup> Stake on the  
 at equal distance thence the distance from the  
 8<sup>th</sup> Stake between the N.E. Corner and the 7<sup>th</sup> Stake on the N side  
 and the 8<sup>th</sup> Stake East of the 7<sup>th</sup> Stake on the center was care-  
 fully measured and the 8<sup>th</sup> Stake on the Center of the  
 N.E. of the Sec was then established at equal  
 distance from the 8<sup>th</sup> Stake N & S, E & W on the 7<sup>th</sup> Sec:

4 Rods Chain was used, The Chainman was sworn  
 according to Law

Remarks

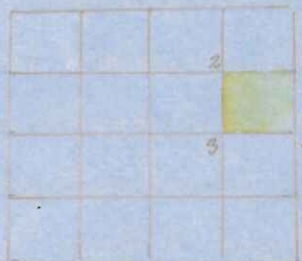

B 7 of 10 1. W Stake 8 N 79 8 72 S W Stake 14 N 75 W 75

" " 9 2. W Stake 24 S 87 E 60 S W Stake 20 N 49 W 56

" " 12 3. W Stake 6 N 45 W 19.

" " 11 4. W Stake 5 S 35 E 6 S W Stake 10 N 80 E W 19

Variation on the N & S, E & W. Line 8°

I hereby certify that the proceedings are correct as stated

O. B. Danks

Be it remembered that on the 3<sup>rd</sup> & 4<sup>th</sup> day  
 of January 1869 I was surveying the W & E of N & E of  
 the N.W. of S.W. of Sec: 14 Town 15. Range 4 West by request  
 of the owner of the same Mr. Christopher Brown  
 and proceeded as follows to wit: The distance from  
 the 7<sup>th</sup> Stake on the North side to that on the South side  
 was carefully measured and found to contain 79 Ch: 8  
 Links, and the distance from the 7<sup>th</sup> Stake on the West  
 side to that on the East side was found to contain