


30 On 17 Links. Thus the  $\frac{1}{4}$  Stake on the line  $\frac{1}{2}$  Line on Centre of the Sec: was established at equal distances from the  $\frac{1}{4}$  Stake on the N & S, E & West side and also the 8 Stake on the two  $\frac{1}{2}$  Lines was estab: at equal distances between the  $\frac{1}{4}$  Stakes; thus the distance from the  $\frac{1}{4}$  Stake on the N side to the NE Corner was measured and found to contain 40 On 21 Links and the 8 Stake on this line estab: at equal distances and also the distance from said NE Corner to the  $\frac{1}{4}$  Stake on the East side, distance was measured and found to contain 59 On 32 Links, Thus the Centre of the NE  $\frac{1}{4}$  was estab: at equal distances from the corresponding 8 Stakes on the E & W, N & S. lines of the  $\frac{1}{2}$  Sec: Thus the distance from the SW Corner of the Sec: was measured to the  $\frac{1}{4}$  Stake on the West side and found to contain 59 On 34 Links and the 8 Stake on this line estab: at equal distances, Thus the 8 Stake on the Centre of the SW  $\frac{1}{4}$  was estab: at equal dist from the corresponding 8 Stakes on the N & S, E & West side of the  $\frac{1}{2}$  Sec: or per diagram & Remarks  
 4 Rods Chain was used. Direction on the N & S, E & W lines  
 30 The Chainman was sworn according to Law

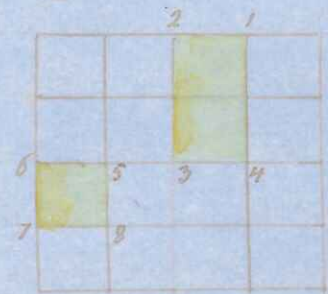

- Remarks
- 2 B T at 1 B Oak N 82 1/2 W 26 1/2 W Oak 5 S 28 1/2 E 18 1/2
  - 3 " " 2 of Oak 10 S 80 E 23 1/2 W Oak 8 N 28 1/2 E 12 1/2 (90)
  - 13 " " 3 B Oak 88 60 W 67 1/2 S B Oak 2 N 69 E 73
  - 12 " " 4 B Oak 5 S 63 W 10 S B Oak 4 N 77 W 5
  - 14 " " 5 B Oak 20 S 81 1/2 E 90 S W Oak 20 S 28 W 26.
  - 15 " " 6 B Oak 12 N 77 1/2 E 60 S W Oak 2 S 37 1/2 W 56
  - 16 " " 7 W Oak 4 S 61 W 44 S W Oak 4 N 31 E 30
  - 17 " " 8 W Oak 30 N 37 1/2 E 157.

I hereby certify that the proceeding or correct or stated  
 OR Doble

Be it remembered that on the 3<sup>rd</sup> & 4<sup>th</sup> day of January 1869 I was surveying the W  $\frac{1}{2}$  of NW  $\frac{1}{4}$  of the NE  $\frac{1}{4}$  of NW  $\frac{1}{4}$  of Sec: 14, 15, 44 by request of the owner of the same Mrs H. Johnson and proceeded as follows The Sec Line was traced from the  $\frac{1}{4}$  Stake on the W side to the NW Corner of the Sec: and the distance from this corner to the  $\frac{1}{4}$  Stake on the N side measured and the 8 Stake on this line estab: at equal distances and at equal distances from the 8 Stake and the 8 Stake on the <sup>North</sup> side of the Centre  $\frac{1}{2}$  Stake