


established and  
 was 1/2 Stake put into the ground at centre of the NW 1/4 of  
 said Sec 4 Rods chain was used the gov corner adjusted  
 after the Field Nols. The Chainman was sworn according  
 to Law

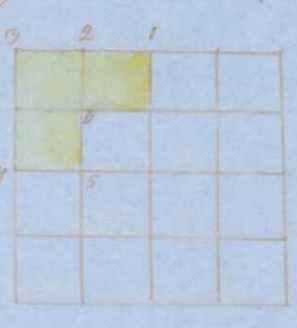

- Remarks
- 3 B S at 1 f. Oaks 10 S 70 E 297 & W Oaks 8 N 28 E 123
  - 4 " " 2 Oaks 5 N 75 W 90 no other tree near
  - 5 " " 3 Double Br Oaks 14 N 16 E 327.
  - 15 " " 4 Swamp Oaks 13 N 77 E 260 & W Oaks 7 S 37 E 155
  - 14 " " 5 Oaks 20 S 31 E 290 & W Oaks 20 S 28 W 26
  - 7 " " 6 1/2 Stake put into the ground no tree near


Verification on the N & S, E & W Lines 8°  
 I hereby certify that the proceedings as aforesaid  
 are correct

*R. Dahl*

Be it remembered that on the 3<sup>rd</sup> & 4<sup>th</sup> day  
 of January 1869 I was surveying the NW 1/4 of Sec 4  
 the NE 1/4 of SW 1/4 & the SE 1/4 of NE 1/4 of Sec 14 town 15. N  
 West by request of the owner of the same Mrs  
 H Paul Erickson and proceeded as follows

The Centre of the Sec: was estab: at equal distance from  
 the 4 Stakes on the N & S side 37 Ch: 93 L and also at equal  
 distance from the 4 Stakes on the E & W side 40 Ch: 9 1/2 L  
 from each of these the 8 Stakes on the E & W side of the  
 1/2 Stake on the centre was estab: at equal distances  
 and also the 8 Stakes on the centre of the SW 1/4 of said Sec:  
 was estab: at equal distance from the 8 Stakes on the  
 E & W, N & S side of the 1/2 Sec: 4 Rods chain was used  
 the Chainman was sworn according to Law

Directions 8°

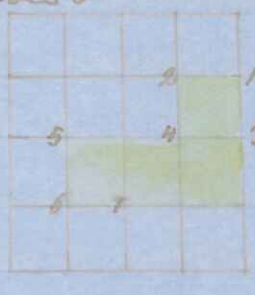

- Remarks
- 10 B S at 1 The middle Oak of 3 W Oaks 4 N 28 E 77 1/2  
W Oaks 3 S 24 E 5
  - 9 " " 2 Willow 9 S 75 E 95 no other tree near
  - 11 " " 3 W Oaks 10 N 62 W 11.63 gov.
  - 12 " " 4 B Oaks 5 S 60 W 10. B Oaks 4 N 77 W 5
  - 14 " " 5 B Oaks 20 S 81 E 290 & W Oaks 20 S 28 W 26
  - 17 " " 6 W Oaks 20 N 37 E 157.
  - 18 " " 7 W Oaks 6 S 60 E 9 1/2

I hereby certify that the proceedings as aforesaid  
 are correct

*R. Dahl*

Be it remembered that on the 3<sup>rd</sup> & 4<sup>th</sup> day  
 of January 1869 I was surveying the NW 1/4 of NE 1/4  
 of Sec: 14. 15. N West by request of the owner of