


He it remembered that on the 25th day of June 1889 I was surveying the NW^{1/4} of Sec 16 Town 16 Range 1 West and partly the NW of SW^{1/4} and Sec. by request of the owner of the same the John Walsh and proceeded as follows to wit:

The distance from the 1/4 Stake on the East side of the Sec. to that on the west side was carefully measured and found to contain 80 Chains. The 1/4 Stake on the west side could not be found on the original site with 139 was buried and this 1/4 Stake was then established by measuring the distance from the NW Corner of the Sec. to the SW Corner distance 80 Chains and the said 1/4 Stake was then put on the right line and at equal distance between the 3 points. Then the distance from the 1/4 Stake on the North side of the Sec. to that on the south side was found to contain 79 Ch: 15 Links and the 1/4 Stake on the center of the Sec. was then estab. at equal distance from the 1/4 Stake on the N & S. & D West side, also the 1/4 Stake on the 1/4 line running E & W was estab. at equal distance 1/2 30 Rods and the 1/4 Stake between the 1/4 Stake on the N side and that on the center was estab. at equal distance 1/2 19 Ch 28 3/4 Links.

Remarks

The Variation of one the N & S Line 8° and one the E & West line 9°. The topography of the ground was carefully observed the gov. corners were erected after the field notes

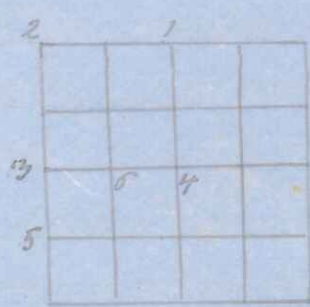

- 3 Burmy tree at 1. 10 Ch 8 1/2 W 70° 12 Ch 6 N 57° 27' 74 (gov.)
- 5 " " 2. 10 Ch 10 N 57° W. 10 Ch 10 S 58° E 19 (gov.)
- 15 " " 3. 10 Ch 3 S 45° E 33 no other tree near.
- 13 " " 4. 10 Ch 10 S 61° E 38 W 6 Ch 6 N 27° E 53 Ch 12 S 73° W 79.
- 16 " " 5. 10 Ch 6 N 11 W 84. 10 Ch 3 S 79° E 7.
- 14 " " 6. 10 Ch 16 S 62° E 204 25. 10 Ch 11 W 43

I here by certify that the proceedings are correct as stated

Or. Dahl
Surveyor

He it remembered that on the 25th of June 1889 I was surveying the N^{1/2} of N^{1/2} of Sec. 10 Town 16 Range 1 West. by request of the owner of the same the Dunbar Range