


on falling to wit the distance from the 4th Stake on the East side to that on the west side was carefully measured & found to contain 80 Chains and the distance from the 4th Stake on the North side to that on the south side was found to contain 79 Chains 15 Links. Thence the 4th Stake on the East side was established at equal distance from the 4th Stake on the East West & South side of the Sec: and the 8th Stake between the 4th Stake on the N side and that on the center of the Sec: was established at equal distance between them being 19 Chs 28 $\frac{1}{2}$ Links between each of them thence the 8th Stake between the center 4th Stake and that on the East side was established at equal distance being 20 Chains between each of them thence the distance between the 4th Stake on the East side and the NE corner of the Sec: was found to contain 39 Ch 24 Links and the 8th Stake on this line was then established 19 Ch 12 Links from each. Thence a right line was measured from the last mentioned 8th Stake to the corresponding 8th Stake on the 4th line distance 39 Ch 34 $\frac{1}{2}$ and the 8th Stake being the center of the NE $\frac{1}{4}$ was then established 19 Ch 9 $\frac{1}{2}$ L. distance between each of them

Remarks

Variation on the E & West lines 9 $^{\circ}$ and on the N & S lines 8 $^{\circ}$ the gov: corners were determined after the field work the topography of the ground was carefully observed

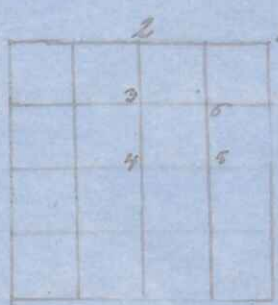

- 1 Near a tree 10 Ch 5 N 49 W 45 $\frac{1}{2}$ & 10 Ch 10 N 38 E 52
- 2 10 Ch 8 S 70 W 70 $\frac{1}{2}$ & 10 Ch 6 N 57 E 74
- 3 10 Ch 9 N 72 E 45 $\frac{1}{2}$ & 10 Ch 3 S 72 E 42
- 4 10 Ch 10 S 68 E 38 $\frac{1}{2}$ & 10 Ch 6 N 77 E 52 & 10 Ch 12 N 73 W 43
- 5 3 rods: 10 Ch 8 N 67 W 102 $\frac{1}{2}$ & 10 Ch 8 N 58 E 108 $\frac{1}{2}$
- 6 10 Ch 4 S 79 E 42 & 10 Ch 4 S 68 E 68
- 7 10 Ch 14 N 20 E 25 $\frac{1}{2}$ No other tree near

I hereby certify that the proceedings were correct as stated

J. R. Dahl

Surveyor

Be it remembered that on the 25th day of June 1859 I was surveying the NE $\frac{1}{4}$ of NE $\frac{1}{4}$ of the 16 town 16 Range West by request of the