


Remarks
 B S at 51. W Oak 8 N 22 W 77 38. W Oak 12 S 37 W 38.
 " " 15 2 W Oak 24 N 50 W 330 & W Oak 8 N 67 1/2 W 375
 " " 13 3 Br Oak 10 N 42 W 94 & Br Oak 12 N 81 & 120.
 " " 3 4 Br Oak 9 N 21 W 172 & W Oak 6 S 62 1/2 W 327

Variation on the N & S. & W lines 8°. The gov corner was adjusted after the field notes. 4 Radr Chain was used. The Chainmen was sworn according to Law
 O. D. Hall
 Surveyor

Be it remembered that on the 9th & 10th day of December 1870 I was surveying Section 25 Town 16 Range 10 East by request of Mr John Bentzen as owner of the NE 1/4 by J. J. Jorgensen as owner of the NE 1/4 of NW 1/4 by E. E. Gregoriusen as owner of the E 1/2 of SE 1/4 by P. H. Anderson as owner of the SW 1/4 of SE 1/4 and by Johannes Foresee as owner of the NW 1/4 of SE 1/4 of said Section. The result of the survey will be observed from the Remarks and Diagram below

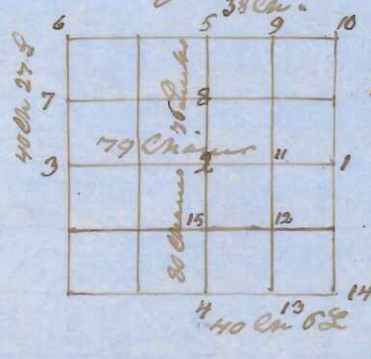

Remarks
 Boundary at 1. W Oak 12 N 70 W 133 & W Oak N 5 E
 " 2 N Oak 10 South 18. & Br Oak 10 N 65 W 8.
 " 3 W Oak 10 S 22 W 74 & W Oak 18 N 59 E 62
 " 4 Br Oak 10 N 15 E 27 & W Oak 10 S 1 E 23
 " 5 N Oak 8 S 2 W 69 & Pine 15 N 82 W 174.
 " 6 W Oak 12 S 75 W 74 Aspen 12 S 51 E 72 (cut off)
 " 7 W Oak 8 S 20 W 11 1/2 & W Oak 5 N 42 E 15.
 " 8 Br Oak 12 N 65 W 100 & Br Oak 6 N 88 54.
 " 9 Br Oak 6 N 46 1/2 W 59 no other tree near.
 " 10 W Oak 7 S 17 1/2 W 83 & W Oak 7 N 34 W 131 & Br Oak 7 N 80 E 99 & Br Oak 7 S 82 E 82
 " 11 Br Oak 4 N 10 E 5 1/2 no other tree near.
 " 12 W Oak 8 N 86 E W 61 & W Oak 10 S 38 W 20
 " 13 Br Oak 10 South 35 no other tree near.
 " 14 W Oak 8 S 74 W 161. W Oak 8 N 60 W 174. & Br Oak 7 N 85 E 98 Br Oak 7 S 64 E 83
 " 15 W Oak 7 S 68 E 10 W Oak 7 N 55 E -

The distance from the 1/4 Pk on the South side to that on the N side was 80 Ch 76 Links and from that on the E to that on the West 79 Ch. The distance from the 1/4 Pk on the S side to that on the E corner of the Sec. 40 Ch 6 Links and from the NE corner to the 1/4 Pk on the North side 38 Chains. from the NW corner to the