


Remarks

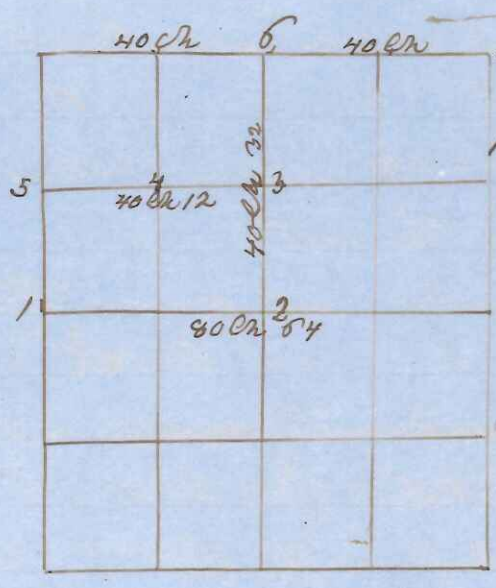

- Bearing tree at 1. Gallon Pine 10 N 85 E 18 Lot
- Gallon " 40 Ch 7 N 88 W 29 Links
- " 13, 2 Tamarac 5 Elm N 33 E Tamarac 7 S 48 W 77.
- " 8 " 3 W Oak 8 S 3 W 10
- " 7 4 Tamarac 5 N 27 W 31.
- " 6 5 do 6 N 7 E Tamarac 6 S 3.
- " 3 8 Pine 20 N 28 E 27 W Pine 18 S 49 W 27

I hereby certify that the proceeding is correct as stated
 O. R. Dahl
 Co Surveyor

I do remember well that on the 11th day of March 1871, I was surveying the 2 1/2th of Lot 2 in Block 31, on the Paul Road Addition to the Village of Towner by request of the owner of the same Mrs Mary Merkley and proceeded as follows to wit: I commenced at the NW corner of said Block thence ^{S 12 E} 50 feet in the same direction to the NE corner of said Lot thence S 12 W 86 feet 8 inches thence N 78 W 50 feet thence N 12 W 86 feet 8 inches to the NW corner of said Lot
 For further particulars see the diagram & Remarks

Remarks

- Figure 1 in Lot 2 is a dwelling house
- " 2 Hitches
- " 3 Pervy
- " 4 Pig pen
- " 5 Barn
- " A Ditch leading the water from Courell Creek to Mrs Remkels Mill Pond



Filed 5/3/00

I hereby certify that the proceeding is correct as stated
 O. R. Dahl
 Co Surveyor